RANCHO SANTIAGO COMMUNITY COLLEGE DISTRICT

ADDENDUM NO. 1

Bid #1384

Purchase of Engineering Equipment for the New Science Center at Santa Ana College

April 3, 2020

Owner:
Rancho Santiago Community College District
2323 North Broadway Room 112
Santa Ana, California 92706

RECEIPT OF THIS ADDENDUM MUST BE ACKNOWLEDGED ON BID FORM WHEN SUBMITTED

The following changes, additions, deletions or corrections shall become a part of the Contract Documents for the project named on the previous page and all other conditions shall remain the same. The Bidders shall be responsible for transmitting this information to all affected prior to the closing of Bids. Prospective Bidders shall acknowledge receipt of this Addendum in the space provided on the Bid Form. Failure to do so may subject Bidder to disqualification.

Item No. AD-1-1

Question:
Please confirm the location of Santa Ana College, New Science Center is 1530 W. 17th St., Santa Ana CA 92706

Answer: Yes, that is correct.

Item No. AD-1-2

Question:
I know the Bid closes on April 14, 2020. You are requiring delivery of the machine between July 31, 2020 and August 13, 2020. When will the bid be awarded? The machines are built to order and will need time to build.

Answer: This bid is tentatively scheduled to be presented to the Board of Trustees on the May 11, 2020 meeting.

Item No. AD-1-3

Question:
Can you tell me about the door entrance to the Delivery location. What are the dimension of the entrance / door. It is easy access to get the machine in? Can we take a forklift in the building. Does anything else have to be moved to get the machine in? I need to know this information for quoting the freight / rigging.

Answer: Please refer to **Attachment A** regarding path of travel for delivery to the engineering lab. Refer to **Attachment B** for the floorplan, mechanical, electrical, and door schedule information. When reviewing door schedule information vendor shall allow for width reduction of 1-1/2" for door leaves. Refer to **Attachment C** for equipment layout information. A forklift cannot enter the building, but a pallet jack would be able to enter the building/lab. Path of travel to the location of delivery will remain clear/open. Relocation of other existing furniture/equipment to place unit(s) is not anticipated.

Item No. AD-1-4
Question:
Training and Demonstration -Page 9 #D How Much training are you requiring per Vendor during August 17 – August 21, 2020

Answer: Vendor to provide standard training package in their bid.

Item No. AD-1-5
Question:
We do not do Seismic Anchorage. You would need to consult a specialist for Seismic Anchorage

Answer: The District's preference is for the Bidder to provide this service. The vendor shall clearly state if this is excluded in the bid for the Haas Compact Mill or the Slant PRO CNC Lathe with Turret.

Item No. AD-1-6
Question:
The Haas CM-1 requires air - Minimum 2scfm, 3/8" inline airline, with minimum constant air pressure 80psi. Will the New Science Center have air available for the Haas CM-1?

Answer: The compressed air pipe for this unit is ½" and the outlet is designed for up to 5 sCFM. The building compressed air is designed for 100 PSI and the outlet pressure at the local regulator is user controllable from 2 to 111 PSI, as set by the user. There should be no trouble meeting the requirements indicated above.

Item No. AD-1-7
Question:
Instron manufactures the 34TM-30 tensile test system. Can we submit a bid for just that one item?

Answer: Yes.

Item No. AD-1-8

Question:

Can the bidder security deposit be waived? Instron is a large company with $200+ million annual sales, we are owned by Illinois Tool Works, a Fortune 150 company with approximately 13 billion dollars of sales. We have the financial stability and wherewithal to accept and carry out this purchase if awarded without any risk on the College's part. We employ 8 field people here in Southern California. In the past few years we have bid on and sold systems to the following Southern California Universities; Cal Poly (2 systems), CSU Channel Islands, Los Angeles Community College, Taft College, UCLA (4 systems), UCI, USC. All of these projects have been successfully completed.

Answer: Pursuant to Public Contract Code section 20651(a), the District is required to have potential bidders provide some form of bid security. Pursuant to Section 8 of the Information for Bidders, bid security is requested "as a guarantee that the bidder will enter into the contract (Purchase Agreement Form), if the same is awarded to such bidder, and will provide any other required documents.

Item No. AD-1-9

Question:

Your RFQ states that the weight of an Instron 34TM-30 is 140 lbs. It is in fact 308 lbs. 140 kg = 308 lbs, so perhaps the units are incorrect. You may wish to correct the RFQ.

Answer: Weight Correction. The weight of the Instron 34TM-30 is 308 lbs.

Item No. AD-1-10

Question:

Instron does not offer inside delivery and cannot dispose of shipping materials. Our customers are expected to receive the delivered machines, unload from truck, unpack, and move them to their final location or resting place. While we can hire a rigger to perform these tasks, it will add a significant amount (about $5,000) or so to the cost. System comes with safe handling instructions. Can we bid without inside installation? If not, can we arrange to have our rigger come on-site before bid so he can give us an estimated cost?

Answer: Vendor is to submit bid including these services. The building is not available to arrange an on-site visit.

Item No. AD-1-11

Question:

You ask for a 2 year warranty and we are happy to bid that way, please be aware that this will increase our price and in earlier discussions with end user any budgetary prices that were given included a one year warranty. So any bid with a two year warranty will be higher. Can I bid with a one year warranty or would you rather a higher price with a two year warranty? Or show 2nd year as an option?

Answer: Vendor is to submit bid based on a 2-year warranty.

Item No. AD-1-12 (Hass CM-1 Dimension Clarification)

The corrected approximate dimensions of the Compact Mill are as follows:
Height: 83”; Depth: 48.2”; Width: 66.5”.

This is the end of ADDENDUM NO. 1

ATTACHMENT A

Delivery Route for Science Center

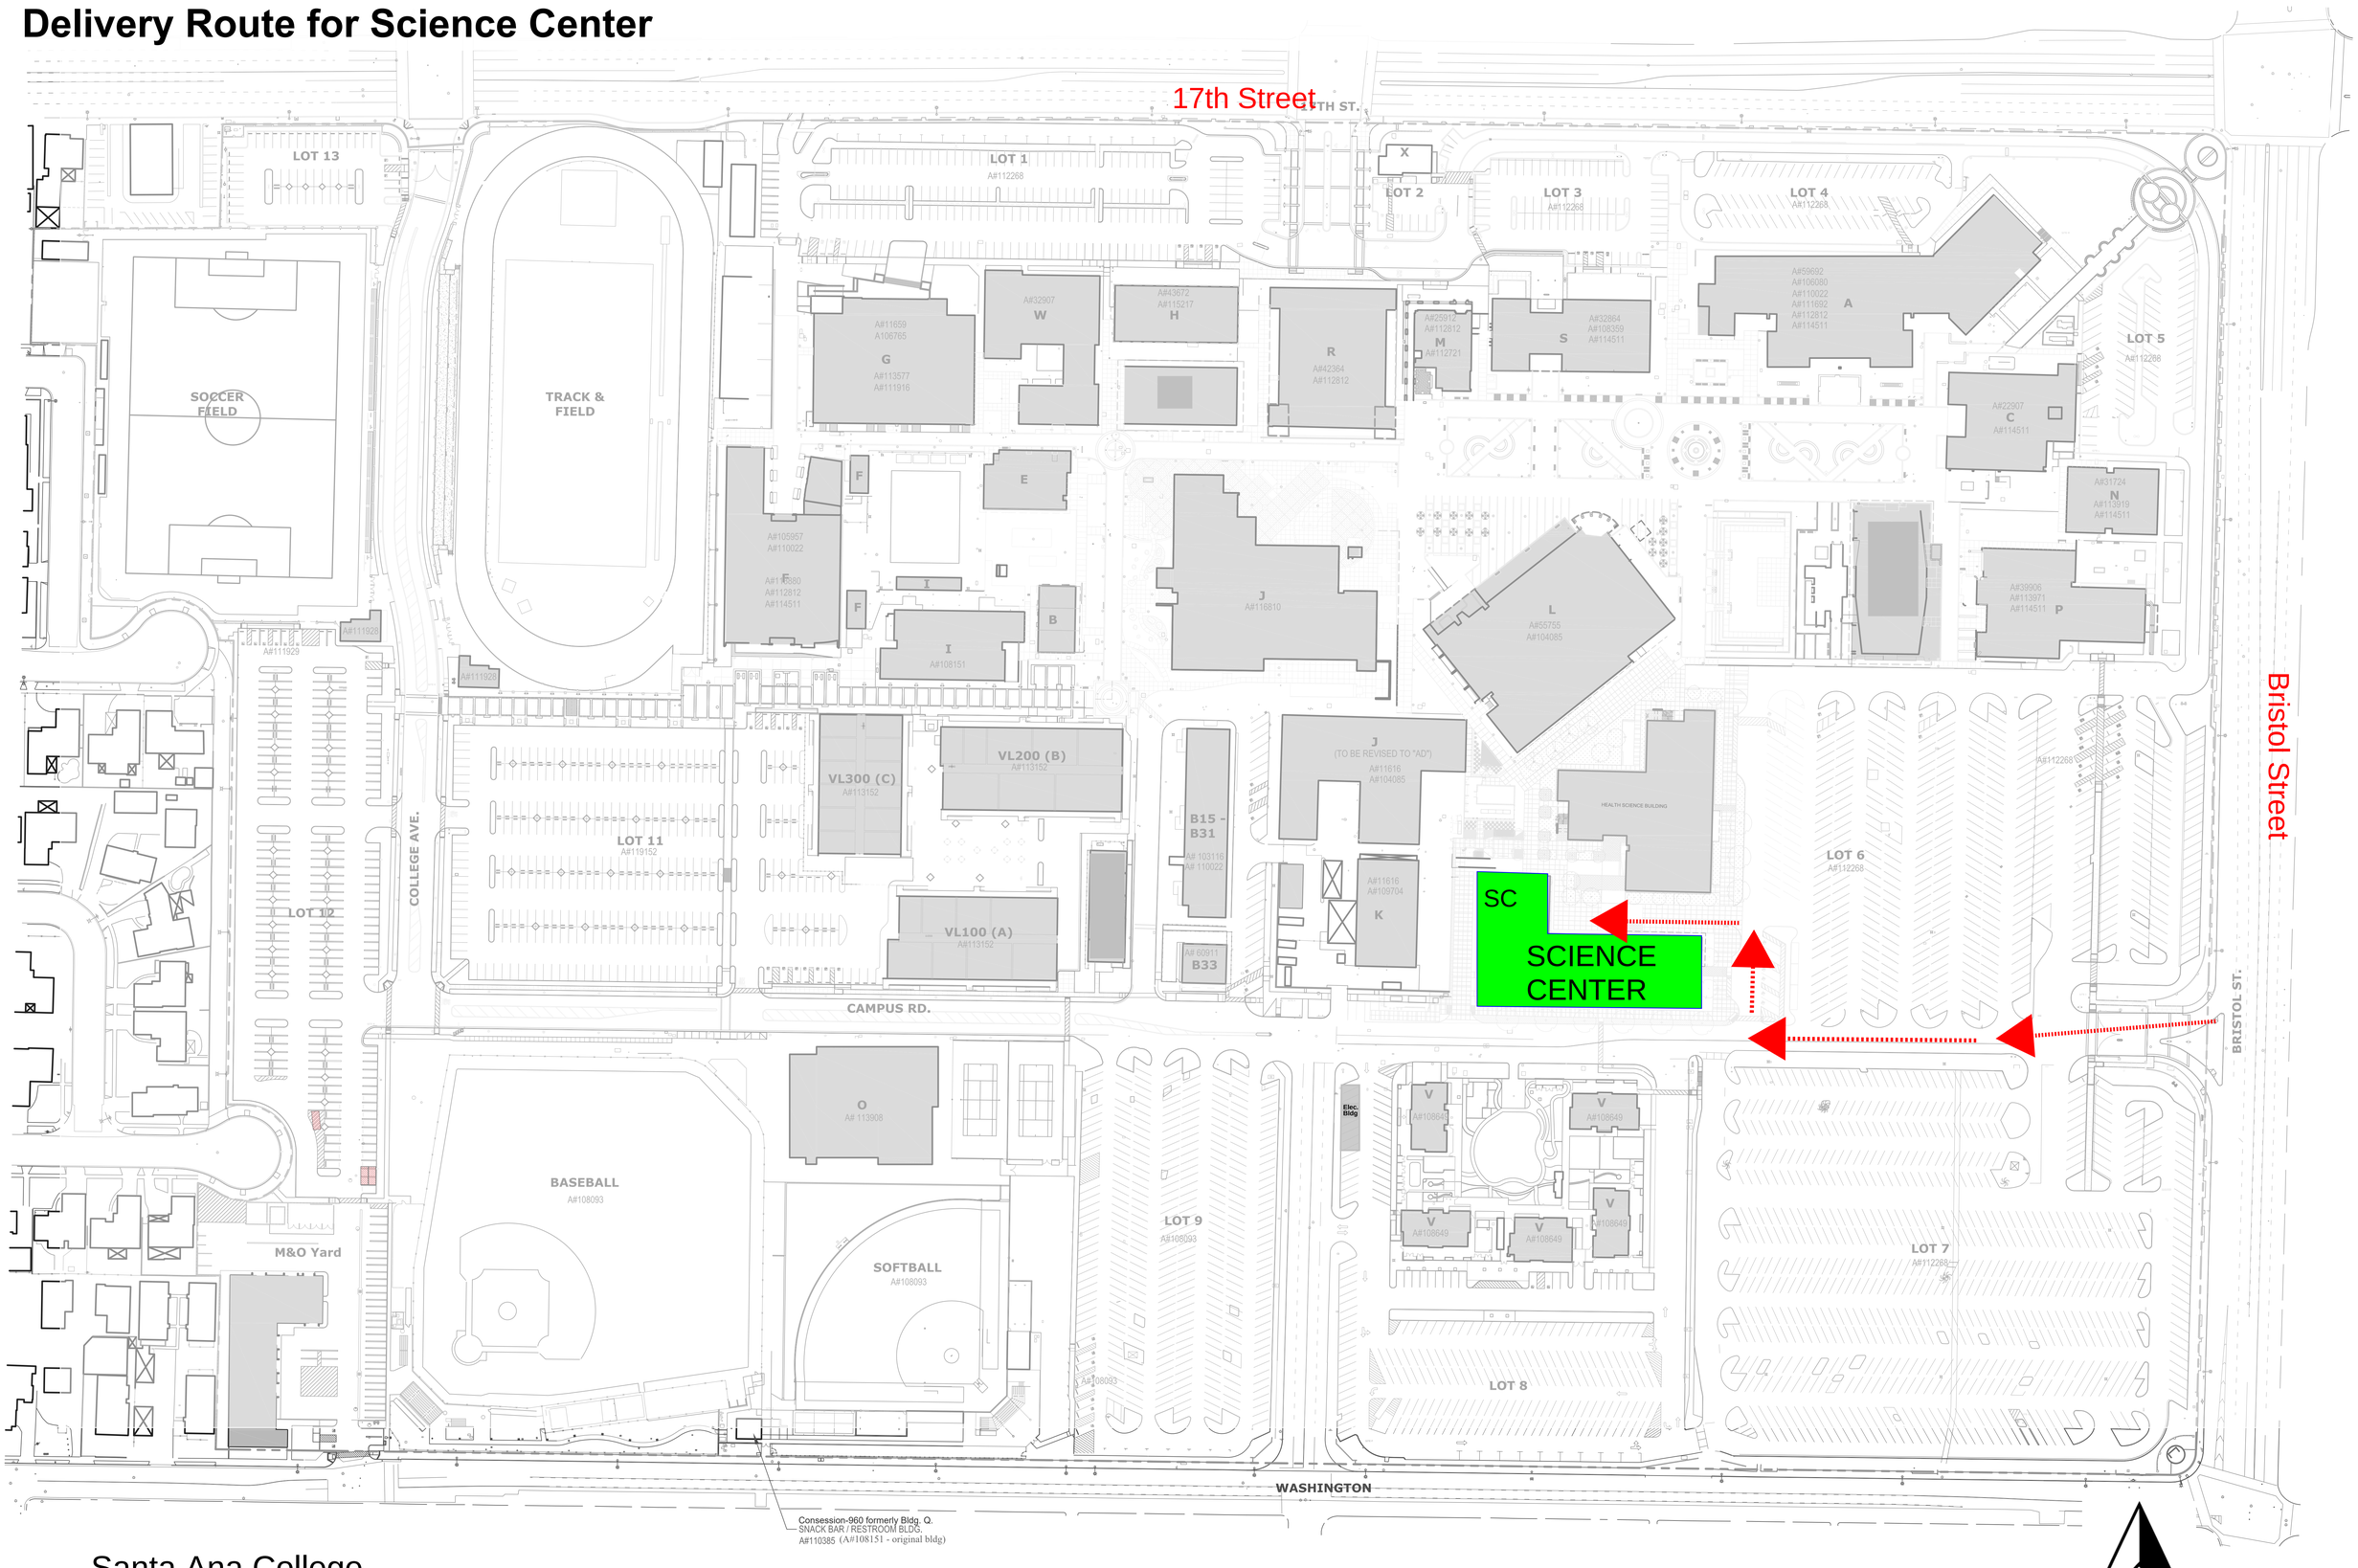

Santa Ana College
1530 W. 17th St.
Santa Ana, CA 92706

ATTACHMENT B

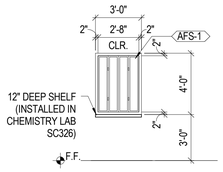

11 F11 - CENTRAL PREP & STORAGE SC322
1/4" = 1'-0"

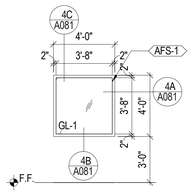

10 F10 - INSTRUMENT RM SC320-1
1/4" = 1'-0"

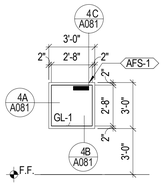

9 F9 - CHEMISTRY PREP & STORAGE SC313
1/4" = 1'-0"

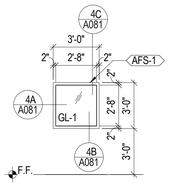

8 F8 - CHEMISTRY PREP & STORAGE SC313
1/4" = 1'-0"

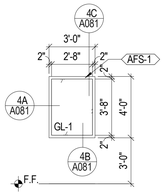

7 F7 - CHEMISTRY PREP & STORAGE SC310
1/4" = 1'-0"

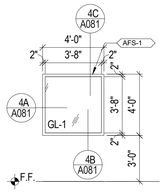

6 F6 - CADAVER RM SC217-1
1/4" = 1'-0"

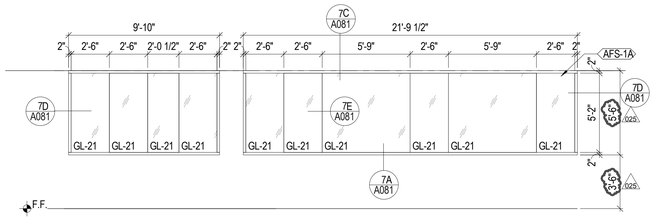

5 F6 - ENGINEERING LAB SC134
1/4" = 1'-0"

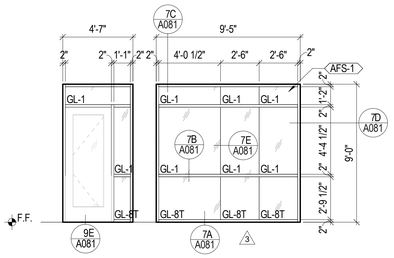

4 F5 - RECEPTION SC116
1/4" = 1'-0"

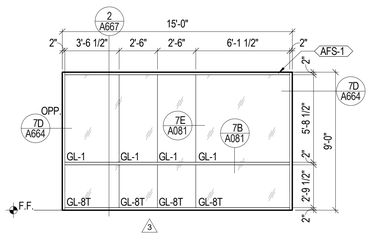

3 F3 - SCIENCE LEARNING CENTER SC103
1/4" = 1'-0"

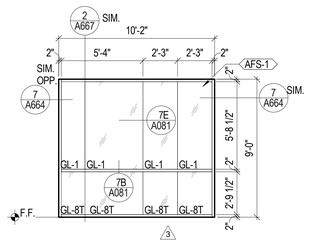

2 F2 - SCIENCE LEARNING CENTER SC103
1/4" = 1'-0"

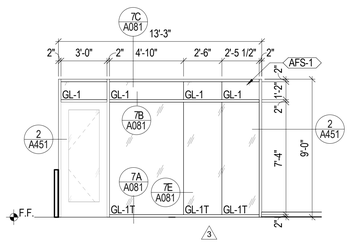

1 F1 - SCIENCE LEARNING CENTER SC103
1/4" = 1'-0"

1918 Main Street, Third Floor
Santa Monica , California 90405
Telephone 310.557.7600

STRUCTURAL ENGINEER
SAIFUL BOUQUET
155 N LAKE AVE
PASADENA, CA 91101
626-304-2616

MECHANICAL & PLUMBING ENGINEER
STANTEC CONSULTING INC
14130 RIVERSIDE DR. # 201
SHERMAN OAKS, CA 91423
818-377-8220

ELECTRICAL ENGINEER
FBA ENGINEERING
150 PAULARINO AVE. #A120
COSTA MESA, CA 92626
949-852-9995

CIVIL ENGINEER
KPFF CONSULTING ENGINEERS
700 SOUTH FLOWER ST. #2100
LOS ANGELES, CA 90017
213-418-0201

LANDSCAPE ARCHITECT
LYNN CAPOUYA, INC.
17992 MITCHELL SOUTH, #110
IRVINE, CA 92614
949-756-0150

LABORATORY CONSULTANT
RESEARCH FACILITIES DESIGN
3965 FIFTH AVE. #400
SAN DIEGO, CA 92103
619-297-0159

SCIENCE CENTER
SANTA ANA COLLEGE

RANCHO SANTIAGO COMMUNITY COLLEGE DISTRICT

1530 W. 17TH ST.
SANTA ANA, CA 92706

SANTA ANA COLLEGE

I HEREBY CERTIFY THAT THIS PLAN, SPECIFICATION OR REPORT WAS PREPARED BY ME OR UNDER MY DIRECT SUPERVISION AND THAT I AM A DULY LICENSED ARCHITECT UNDER THE LAWS OF THE STATE OF CALIFORNIA

NAME: KEVIN DONAGHEY
DATE: MAY 16, 2017
REGISTRATION NUMBER: C34799

APPROVED
DIVISION OF THE STATE ARCHITECT

ACS MP FLS JA SSR CNg

A# 04-115788 DATE: 09.11.18

NO	DESCRIPTION	DATE
3	Addendum 3	9/22/17
05	RFI#5	12/18/17
025	CCD-A-025	08/29/18

ISSUANCE HISTORY - THIS SHEET

DRAWN BY: MS | REVIEW BY: Approver

HGA NO: 3584-001-00

INTERIOR GLAZING ELEVATIONS

DATE: JULY 06, 2017

A630

© COPYRIGHT HAMMEL, GREEN AND ABRAHAMSON, INC.

MS 9/7/2018 11:37:56 AM C:\Users\msilva\Documents\A16-3584-001-00_SAC-SC_Interior.rvt

RFI 558

RFI 577

DOOR NUMBER	ROOM NAME	DOOR WIDTH	DOOR HEIGHT	DOOR TYPE	GLAZING TYP	DOOR FINISH	FRAME TYPE	FRAME GLAZING TYP	FRAME FINISH	DETAILS HEAD	DETAILS JAMB	SILL/ THRESHOLD	RATING (MIN)	HDWE GROUP	ELEC	ALARM	SECURITY TYPE	NOTES
100-1A	CORRIDOR	6' - 0"	7' - 6"	STL-FR	GL-63 (3)	NOTE 9	SF3	GL-63 (3)	NOTE 9	6/A443	3/A443	10D/A081	60 MIN.	SH-1	X	X	CR (011b)	PH, ADO
100A	CORRIDOR	6' - 0"	7' - 6"	STL-FR	GL-63	NOTE 9	SF5	GL-63	NOTE 9	6/A443	3/A443	10D/A081	60 MIN.	SH-1A	X	X	CR	PH, ADO
100B	CORRIDOR	6' - 0"	8' - 0"	AL	GL-1T	NOTE 8	CW3	GL-1T	NOTE 8	2/A434	1/A456	10D/A081	--	SH-1A.1	X	X	CR	PH, ADO
101A	RESTROOM	3' - 0"	7' - 6"	HM-F	--	PT-2D	HM-001	--	PT-5D	6B/A081	6A/A081	9E/A081	--	HW-2	--		--	--
102A	MEN'S RESTROOM	3' - 0"	7' - 6"	HM-F	--	PT-2D	HM-001	--	PT-5D	6B/A081	6A/A081	9E/A081	--	HW-1	--	--	--	--
103-1A	MODEL STORAGE / LOCKERS	3' - 0"	7' - 6"	WD-F	--	WD-1	HM-001	--	PT-5D	6B/A081	6A/A081	9B/A081	--	SH-2B.1 (011b)	--	(011b) --	(011b) CR	--
103-2A	WORK ROOM	3' - 0"	7' - 6"	AL-FG	GL-1T	PT-5D	F1	--	PT-5D	5B/A081	2/A451	-- (4)	--	HW-1B (013)	--	(013) --	--	--
103A	SCIENCE LEARNING CENTER	3' - 0"	7' - 6"	WD-NV	GL-62	WD-1	HM-100A	GL-62	PT-5D	3B/A081	3A/A081	9C/A081	45 MIN.	SH-7A	--	X	CR	WMR, PH, DPS
103B	SCIENCE LEARNING CENTER	3' - 0"	8' - 0"	AL-FG	GL-1T (3)	NOTE 7	SF1	GL-1T (3)	NOTE 7	1/A431 TYP.	4/A456	10D/A081	--	SH-6	--	X	CR	--
103C	SCIENCE LEARNING CENTER (011b)	10' - 2"	11' - 0"	CD-1	--	--	--	--	--	2/A667	7/A664	-- (4)	90 MIN.	MFR	X	X (011b)	--	--
103D	SCIENCE LEARNING CENTER	15' - 0"	11' - 0"	CD-1	--	--	--	--	--	2/A667	7/A664	-- (4)	90 MIN.	MFR	X	X (013)	--	--
104A	WOMEN'S RESTROOM	3' - 0"	7' - 6"	HM-F	--	PT-2D	HM-001	--	PT-5D	6B/A081	6A/A081	9E/A081	--	HW-1	--	--	--	--
105A	LOBBY	6' - 0"	8' - 0"	AL	GL-1T (3)	NOTE 8	CW1	GL-1T (3)	NOTE 8	1/A431	1/A452	10D/A081	--	SH-1A.1	X	X	CR	PH, ADO
105B	LOBBY	6' - 0"	8' - 0"	AL	GL-1T	NOTE 8	CW1	GL-1T	NOTE 8	1/A431	1/A452	10D/A081	--	SH-4	--	X	CR	PH, DPS
106A	CUSTODIAL	3' - 0"	7' - 6"	HM-F	--	PT-2D	HM-001	--	PT-5D	6B/A081	6A/A081		--	HW-5	--	--	--	--
107A	MACHINE ROOM	4' - 0"	7' - 6"	HM-F	--	PT-2D	HM-001	--	PT-5D	6B/A081	6A/A081	-- (4)	45 MIN.	SH-5A	--	X	--	--
109A	BDF	4' - 0"	7' - 6"	HM-F	--	PT-4D	HM-001	--	PT-4D	6B/A081	6A/A081	--	45 MIN.	SH-2A.1	--	X	CR	--
110A	VESTIBULE	3' - 0"	7' - 6"	WD-NV	GL-1	WD-1	HM-110A	GL-7(T), GL-1	PT-5D	2B/A081	2A/A081	10B/A081	--	SH-2B.1	--	X	CR	
110C	CONFERENCE	3' - 0"	7' - 6"	WD-NV	GL-1	WD-1	HM-100A	GL-1	PT-5D	6B/A081	6A/A081	9B/A081	--	HW-1A	--	--	--	-- (2)
111A	LARGE CLASSROOM	3' - 0"	7' - 6"	WD-NV	GL-62	WD-1	HM-110A	GL-62T GL-7(T)	PT-5D	3B/A081	3A/A081	--	45 MIN.	SH-9	--	X	CR	PH
111B	LARGE CLASSROOM	3' - 0"	7' - 6"	WD-NV	GL-62	WD-1	HM-110A	GL-62T GL-7(T)	PT-5D	3B/A081	3A/A081	--	45 MIN.	SH-9A	--	X	I/L111A	PH, WMR, ADB
113-1A	LARGE CLASSROOM (DIVISIBLE)	3' - 0"	7' - 6"	WD-NV	GL-62	WD-1	HM-110A	GL-62T GL-7(T)	PT-5D	3B/A081	3A/A081	--	45 MIN.	SH-9A	--	X	CR	PH
113-2A	LARGE CLASSROOM (DIVISIBLE)	3' - 0"	7' - 6"	WD-NV	GL-62	WD-1	HM-110A	GL-62T GL-7(T)	PT-5D	3B/A081	3A/A081	-- (4)	45 MIN.	SH-9	--	X	CR	PH
114A	ELECTRICAL CLOSET	6' - 0"	7' - 6"	HM-F	--	PT-2D	HM-001	--	PT-5D	6B/A081	6A/A081	--	--	SH-14	--	X	--	--
114B	ELECTRICAL CLOSET	6' - 0"	7' - 6"	HM-F	--	PT-2D	HM-001	--	PT-5D	6B/A081	6A/A081	--	--	SH-14	--	X	--	--
115-2A	OFFICE	3' - 0"	7' - 6"	WD-NV	GL-1	WD-1	HM-100A	GL-1	PT-5D	2B/A081	2A/A081	10B/A081	-- (011b)	HW-3	--	X (013)	--	ADB
115-3A	OFFICE	3' - 0"	7' - 6"	WD-NV	GL-1	WD-1	HM-100A	GL-1	PT-5D	2B/A081	2A/A081	10B/A081	--	HW-3	--	X	--	ADB
115-4A	OFFICE	3' - 0"	7' - 6"	WD-NV	GL-1	WD-1	HM-100A	GL-1	PT-5D	2B/A081	2A/A081	10B/A081	--	HW-3	--	X	--	ADB
115A	CORRIDOR	3' - 0"	7' - 6"	WD-NV	GL-62	WD-1	HM-110A	GL-62T GL-7(T)	PT-5D	3B/A081	3A/A081	-- (4)	--	SH-2B	--	X	CR	
116-1A	WORK ROOM	3' - 0"	7' - 6"	WD-NV	GL-1	WD-1	HM-100A	GL-1	PT-5D	6B/A081	6A/A081	10B/A081	--	SH-2B.1	--	X	(011b) CR	--
116-1B	OFFICE	3' - 0"	7' - 6"	WD-NV	GL-1	WD-1	HM-001	GL-1	PT-5D	6B/A081	6A/A081	10B/A081	(011b) --	HW-3	--	X (013)	--	--
116A	RECEPTION	3' - 0"	7' - 6" (045b)	AL-FG	GL-1T	PT-5D	F5	--	PT-5D	2B/A081	2A/A081	9C/A081	-- (013)	SH-15	--	X	CR	I/L
116B	RECEPTION	3' - 0"	2' - 6"	WD-F	--	PLAM-2	--	--	PT-5D	--	6A/A081	--	-- (2)	HW-3B	--	--	--	DOUBLE ACTING
118A	GEOLOGY / EARTH SCIENCE LAB	3' - 0"	7' - 6"	WD-NV	GL-1	WD-1	HM-110A	GL-7(T), GL-1	PT-5D	2B/A081	2A/A081	10B/A081	--	SH-2B.3	--	X	CR	ADB
118B	GEOLOGY / EARTH SCIENCE LAB	4' - 6"	7' - 6"	WD-NV2	GL-1	WD-1	HM-100A	GL-1	PT-5D	2B/A081	6A/A081	10B/A081	--	SH-7E	--	X	I/L 118A	ADB, UNEQUAL: 3'-0", 1'-6"
120A	GEOLOGY / PHYSICAL SCIENCE PREP & STORAGE	4' - 6"	7' - 6"	WD-NV2 (013)	GL-1 (011b)	WD-1	HM-100A	GL-1	PT-5D	2B/A081	6A/A081	--	-- (011b)	SH-7B	--	X	(011b) CR	UNEQUAL: 3'-0", 1'-6"
120B	GEOLOGY / PHYSICAL SCIENCE LAB & LECTURE	3' - 0"	7' - 6"	WD-NV	GL-1	WD-1	HM-001	--	PT-5D	6B/A081	6A/A081	--	-- (013)	SH-12	(2) --	-- (013)	CR	--
120C	GEOLOGY / EARTH SCIENCE LAB	3' - 0"	7' - 6"	WD-NV	GL-1	WD-1	HM-001	--	PT-5D	6B/A081	6A/A081	-- (4)	--	SH-12	--	--	CR	--
122A	GEOLOGY / PHYSICAL SCIENCE LAB & LECTURE	3' - 0"	7' - 6"	WD-NV	GL-1	WD-1	HM-110A	GL-7(T), GL-1	PT-5D	2B/A081	2A/A081	10B/A081	--	SH-2B.3	--	X	(2) CR	--
122B	GEOLOGY / PHYSICAL SCIENCE LAB & LECTURE	4' - 6"	7' - 6"	WD-NV2	GL-1 (3)	WD-1	HM-100A	GL-1 (3)	PT-5D	2B/A081	6A/A081	--	--	SH-7E	--	X	I/L 122A	ADB, UNEQUAL: 3'-0", 1'-6"
124A	STORAGE	3' - 0"	7' - 6"	HM-F	--	PT-2D	HM-001	--	PT-5D	6B/A081	6A/A081	9C/A081 SIM.	--	SH-12	--	X	CR	--
126A	EMERGENCY ELECTRICAL	3' - 0"	7' - 6"	HM-F	--	NOTE 6	HM-001	--	NOTE 6	6B/A081	6A/A081	10A/A081	--	SH-8	--	X	--	PH
128A	MECHANICAL ROOM	6' - 0"	7' - 6"	HM-F	--	NOTE 6	HM-001	--	NOTE 6	6B/A081	6A/A081	10A/A081	--	SH-5	--	X	--	
128B	MECHANICAL ROOM	3' - 0"	7' - 6"	HM-F	--	PT-2D	HM-001	--	PT-5D	6B/A081	6A/A081	9D/A081	--	SH-2A	--	X	CR	--
130A	MAIN ELECTRICAL	4' - 0"	7' - 6"	HM-F	--	PT-2D	HM-001	--	PT-5D	6B/A081	6A/A081	9D/A081	45 MIN.	SH-13	--	X	--	PH
132A	ENGINEERING PREP & STORAGE	3' - 0"	7' - 6"	WD-NV	GL-1 (3)	WD-1	HM-110A	GL-7(T), GL-1 (3)	PT-5D	2B/A081	2A/A081	9D/A081	--	SH-12	--	X	(011b) CR	--
132B	ENGINEERING PREP & STORAGE	3' - 0"	7' - 6"	WD-NV	GL-1	WD-1	HM-001	--	PT-5D	6B/A081	6A/A081	--	--	SH-12	--	--	(013) CR	--
134A	ENGINEERING LAB	3' - 0"	7' - 6"	WD-NV (013)	GL-1	WD-1	HM-110A	GL-7(T), GL-1	PT-5D	2B/A081	2A/A081	10B/A081 (4)	--	SH-2B.3	--	X	CR	ADB
134B	ENGINEERING LAB	6' - 0"	7' - 6"	WD-NV	GL-1 (3)	WD-1	HM-100A	GL-1 (3)	PT-5D	2B/A081	2A/A081	10B/A081	--	SH-11B	--	--	I/L 134A	EPH, ADB (035)
136A	FIRE RISER RM	3' - 0"	7' - 6"	HM-F	--	PT-2D	HM-001	--	PT-5D	6B/A081	6A/A081	9D/A081	--	HW-5D	--	--	--	-
200-1A	CORRIDOR	6' - 0"	7' - 6"	STL-FR	GL-63	NOTE 9	SF3	GL-63	NOTE 9	6/A443	3/A443	--	60 MIN.	SH-1B	X	X	CR	PH
200-1B	CORRIDOR	3' - 0"	7' - 6"	WD-NV	GL-62	WD-1	HM-001	--	PT-5D	2B/A081	2A/A081	9B/A081	45 MIN.	HW-7	--	--	--	PH, MHO
200-1C	STAIR #2	3' - 0"	7' - 6"	GATE	--	PT-5E	--	--	--	NOTE 4	NOTE 4	--	--	HW-20	--	--	--	PH
200A	CORRIDOR	6' - 0"	7' - 6"	STL-FR	GL-63	NOTE 9	SF5	GL-63	NOTE 9	6/A443	3/A443	10D/A081	60 MIN.	SH-1B	X	X	(011b) CR	PH
200B	STAIR #1	3' - 0"	7' - 6"	GATE	--	PT-5E	--	--	--	NOTE 4	NOTE 4	--	-- (011b)	HW-20	--	--	--	PH
201-1A	OFFICE	3' - 0"	7' - 6"	WD-NV	GL-1	WD-1	HM-100A	GL-1	PT-5D	2B/A081	2A/A081	10B/A081	-- (013)	HW-3	--	X	--	ADB
201-2A	OFFICE	3' - 0"	7' - 6"	WD-NV	GL-1	WD-1	HM-100A	GL-1	PT-5D	2B/A081	2A/A081	10B/A081	--	HW-3	--	X	--	ADB
201-3A	OFFICE	3' - 0"	7' - 6"	WD-NV	GL-1	WD-1	HM-100A	GL-1	PT-5D	2B/A081	2A/A081	10B/A081	--	HW-3	--	X	--	ADB
201-4A	OFFICE	3' - 0"	7' - 6"	WD-NV	GL-1	WD-1	HM-100A	GL-1	PT-5D	2B/A081	2A/A081	10B/A081	--	HW-3	--	X	--	ADB
201-5A	OFFICE	3' - 0"	7' - 6"	WD-NV	GL-1	WD-1	HM-100A	GL-1	PT-5D	2B/A081	2A/A081	10B/A081	--	HW-3	--	X	--	ADB
201-6A	OFFICE	3' - 0"	7' - 6"	WD-NV	GL-1	WD-1	HM-100A	GL-1	PT-5D	2B/A081	2A/A081	10B/A081	--	HW-3	--	X	--	ADB
201-7A	OFFICE	3' - 0"	7' - 6"	WD-NV	GL-1	WD-1	HM-100A	GL-1	PT-5D	2B/A081	2A/A081	10B/A081	--	HW-3	--	X	--	ADB
201A	CORRIDOR	3' - 0"	7' - 6"	WD-NV	GL-1	WD-1	HM-110A	GL-7(T), GL-1	PT-5D	2B/A081	2A/A081	10B/A081	--	SH-2B.1	--	X	CR	ADB
201B	CORRIDOR	3' - 0"	7' - 6"	WD-F	--	WD-1	HM-001	--	PT-5D	6B/A081	6A/A081	10B/A081	--	SH-2.1	--	X	CR	ADB
202A	MEN'S RESTROOM	3' - 0"	7' - 6"	HM-F	--	PT-2D	HM-001	--	PT-5D	6B/A081	6A/A081	9E/A081 (4)	--	HW-1	--	--	--	-- (2)
203A	RESTROOM	3' - 0"	7' - 6"	HM-F	--	PT-2D	HM-001	--	PT-5D	6B/A081	6A/A081	9E/A081	--	HW-2	--	--	--	--
204A	WOMEN'S RESTROOM	3' - 0"	7' - 6"	HM-F	--	PT-2D	HM-001	--	PT-5D	6B/A081	6A/A081	9E/A081	--	HW-1	--	--	--	--
206A	CUSTODIAL	3' - 0"	7' - 6"	HM-F	--	PT-2D	HM-001	--	PT-5D	6B/A081	6A/A081	9D/A081	--	HW-5	--	--	--	--
208A	CLASSROOM	3' - 0"	7' - 6"	WD-NV	GL-1	WD-1	HM-110A	GL-7(T), GL-1	PT-5D	2B/A081	2A/A081	10B/A081	--	SH-2B.3	--	X	CR	ADB
209A	LACTATION ROOM	3' - 0"	7' - 6"	HM-F	--	PT-2D	HM-001	--	PT-5D	6B/A081	6A/A081	--	--	HW-3C	--	--	--	--
210A	ELEC. CLOSET	3' - 0"	7' - 6"	HM-F	--	PT-2D	HM-001	--	PT-5D	6B/A081	6A/A081	9D/A081	--	HW-5	--	--	--	--
211A	IDF	4' - 0"	7' - 6"	HM-F	--	PT-2D	HM-001	--	PT-5D	6B/A081	6A/A081	9D/A081	--	SH-2A	--	X	CR	--
212A	MOLECULAR BIOLOGY LAB	4' - 6"	7' - 6"	WD-NV2	GL-1	WD-1	HM-100A	GL-1	PT-5D	2B/A081	6A/A081	10B/A081	--	SH-7B	--	X	CR	ADB, UNEQUAL: 3'-0", 1'-6"
212B	MOLECULAR BIOLOGY LAB	3' - 0"	7' - 6"	WD-NV	GL-1	WD-1	HM-110A	GL-7(T), GL-1	PT-5D	2B/A081	2A/A081	10B/A081	--	SH-2B	--	X	I/L212A	ADB
213A	PHYSIOLOGY LAB	4' - 6"	7' - 6"	WD-NV2 (011b)	GL-1	WD-1	HM-100A	GL-1	PT-5D	2B/A081	6A/A081	10B/A081	--	SH-7E	--	X	CR	ADB, UNEQUAL: 3'-0", 1'-6"
213B	PHYSIOLOGY LAB	3' - 0"	7' - 6"	WD-NV	GL-1 (013)	WD-1	HM-110A	GL-7(T), GL-1	PT-5D	2B/A081	2A/A081	10B/A081	(011b) --	SH-2B	--	X	(011b) I/L213A	ADB
213C	PHYSIOLOGY LAB	3' - 0"	7' - 6"	WD-NV	GL-1	WD-1	HM-001	--	PT-5D	6B/A081	6A/A081	--	-- (013)	SH-12	--	--	(013) CR	--
214A	MOLECULAR BIOLOGY PREP & STORAGE	4' - 6"	7' - 6"	WD-NV2	GL-1	WD-1	HM-100A	GL-1	PT-5D	2B/A081	6A/A081	--	--	SH-7B	--	X	CR	UNEQUAL: 3'-0", 1'-6"

DOOR NUMBER	ROOM NAME	DOOR WIDTH	DOOR HEIGHT	DOOR TYPE	GLAZING TYP	DOOR FINISH	FRAME TYPE	FRAME GLAZING TYP	FRAME FINISH	DETAILS HEAD	DETAILS JAMB	SILL/ THRESHOLD	RATING (MIN)	HDWE GROUP	ELEC	ALARM	SECURITY TYPE	NOTES
214B	MICROBIOLOGY LAB	3' - 0"	7' - 6"	WD-NV	GL-1 (013)	WD-1	HM-001	--	PT-5D	6B/A081	6A/A081	--	-- (011b)	SH-12	--	--	CR (011b)	--
214C	MOLECULAR BIOLOGY LAB	3' - 0"	7' - 6"	WD-NV	GL-1 (011b)	WD-1	HM-001	--	PT-5D	6B/A081	6A/A081	--	--	SH-12	--	--	CR (013)	--
215A	ANATOMY & PHYSIOLOGY PREP & STORAGE	3' - 0"	7' - 6"	WD-NV	GL-1	WD-1	HM-110A	GL-7(T)	PT-5D	2B/A081	2A/A081	--	--	SH-2D	--	X	CR	--
215B	ANATOMY LAB	3' - 0"	7' - 6"	WD-NV	GL-1 (011b)	WD-1	HM-001	--	PT-5D	6B/A081	6A/A081	--	-- (011b)	SH-2	--	--	CR (011b)	--
216A	MICROBIOLOGY LAB	4' - 6"	7' - 6"	WD-NV2	GL-1 (013)	WD-1	HM-100A	GL-1	PT-5D	2B/A081	6A/A081	--	--	SH-7 (013)	--	X	I/L216B	PH, UNEQUAL: 3'-0", 1'-6"
216B	MICROBIOLOGY LAB	3' - 0"	7' - 6"	WD-NV	GL-1	WD-1	HM-110A	GL-7(T) , GL-1	PT-5D	2B/A081	2A/A081	--	--	SH-2B	--	--	CR	--
217-1A	CADAVER ROOM	3' - 0"	7' - 6"	WD-NV	GL-1 (011b)	WD-1	HM-001	--	PT-5D	6B/A081	6A/A081	10B/A081	--	SH-2C	--	--	CR (011b)	ADB
217A	ANATOMY LAB	3' - 0"	7' - 6"	WD-NV	GL-1	WD-1	HM-110A	GL-1	PT-5D	2B/A081	2A/A081	--	-- (013)	SH-2B	--	X	CR (013)	-- (2)
217B	ANATOMY LAB	4' - 6"	7' - 6"	WD-NV2	GL-1	WD-1	HM-100A	GL-7(T) , GL-1	PT-5D	2B/A081	6A/A081	--	--	SH-7	(011b)	X	I/L 217A	UNEQUAL: 3'-0", 1'-6"
218A	GENERAL BIOLOGY LAB	3' - 0"	7' - 6"	WD-NV	GL-1	WD-1	HM-110A	GL-7(T) , GL-1	PT-5D	2B/A081	2A/A081	--	--	SH-2C	--	X	CR	--
218B	GENERAL BIOLOGY LAB	4' - 6"	7' - 6"	WD-NV2	GL-1 (011b)	WD-1	HM-100A	GL-1	PT-5D	2B/A081	6A/A081	--	--	SH-7B	--	X	I/L 218A	DPS, UNEQUAL: 3'-0", 1'-6"
220A	ORGANISMAL BIOLOGY LAB	3' - 0"	7' - 6"	WD-NV	GL-1 (013)	WD-1	HM-001	--	PT-5D	6B/A081	6A/A081	--	-- (011b)	SH-12	--	--	(013) CR (011b)	--
220B	GENERAL BIOLOGY LAB	3' - 0"	7' - 6"	WD-NV	GL-1	WD-1	HM-001	--	PT-5D	6B/A081	6A/A081	--	--	SH-12	--	--	CR	--
220C	GENERAL & ORGANISMAL PREP & STORAGE	4' - 6"	7' - 6"	WD-NV2	GL-1	WD-1	HM-100A	GL-1	PT-5D	2B/A081	6A/A081	--	--	SH-7B	--	X	CR	UNEQUAL: 3'-0", 1'-6"
222A	WASTE	3' - 0"	7' - 6"	HM-F	(013)	PT-2D	HM-001	--	PT-5D	6B/A081	6A/A081	10A/A081	--	SH-2B.1	--	X	CR	ADB
224A	ELEC. CLOSET	6' - 0"	7' - 6"	HM-F	--	PT-2D	HM-001	--	PT-5D	6B/A081	6A/A081	9D/A081	--	SH-14	--	X	--	--
224B	ELEC. CLOSET	6' - 0"	7' - 6"	HM-F	--	PT-2D	HM-001	--	PT-5D	6B/A081	6A/A081	9D/A081	--	SH-14	--	X	--	--
226A	ORGANISMAL BIOLOGY LAB	3' - 0"	7' - 6"	WD-NV	GL-1	WD-1	HM-110A	GL-7(T) , GL-1	PT-5D	2B/A081	2A/A081	9B/A081	--	SH-2B	--	X	CR	--
226B	ORGANISMAL BIOLOGY LAB	4' - 6"	7' - 6"	WD-NV2	GL-1 (3)	WD-1	HM-100A	GL-1 (3)	PT-5D	2B/A081	6A/A081	--	--	SH-7	--	X	I/L 226A	UNEQUAL PAIR: 3'-0", 1'-6"
300-1A	CORRIDOR	6' - 0"	7' - 6"	STL-FR	GL-63	NOTE 9	SF4	GL-63	NOTE 9	6/A443	3/A443	10D/A081	60 MIN.	SH-1B	--	X	CR	PH
300A	CORRIDOR	6' - 0"	7' - 6"	STL-FR	GL-63	NOTE 9	SF5	GL-63	NOTE 9	6/A443	3/A443	10D/A081	60 MIN.	SH-1B	--	X	CR	PH
301-1A	OFFICE	3' - 0"	7' - 6"	WD-NV	GL-1 (011b) (013)	WD-1	HM-100A	GL-1	PT-5D	2B/A081	2A/A081	10B/A081	-- (011b)	HW-3	--	X	-- (011b)	ADB
301-2A	OFFICE	3' - 0"	7' - 6"	WD-NV	GL-1	WD-1	HM-100A	GL-1	PT-5D	2B/A081	2A/A081	10B/A081	-- (013)	HW-3	--	X	--	ADB
301-3A	OFFICE	3' - 0"	7' - 6"	WD-NV	GL-1	WD-1	HM-100A	GL-1	PT-5D	2B/A081	2A/A081	10B/A081	--	HW-3	--	X	-- (013)	ADB
301-4A	OFFICE	3' - 0"	7' - 6"	WD-NV	GL-1	WD-1	HM-100A	GL-1	PT-5D	2B/A081	2A/A081	10B/A081	--	HW-3	--	X	--	ADB
301-5A	OFFICE	3' - 0"	7' - 6"	WD-NV	GL-1	WD-1	HM-100A	GL-1	PT-5D	2B/A081	2A/A081	10B/A081	--	HW-3	--	X	--	ADB
301-6A	OFFICE	3' - 0"	7' - 6"	WD-NV	GL-1	WD-1	HM-100A	GL-1	PT-5D	2B/A081	2A/A081	10B/A081	--	HW-3	--	X	--	ADB
301-7A	OFFICE	3' - 0"	7' - 6"	WD-NV	GL-1	WD-1	HM-100A	GL-1	PT-5D	2B/A081	2A/A081	10B/A081	--	HW-3	--	X	--	ADB
301A	CORRIDOR	3' - 0"	7' - 6"	WD-NV	GL-1	WD-1	HM-110A	GL-7(T) , GL-1	PT-5D	2B/A081	2A/A081	10B/A081 (4)	---	SH-2B	--	X	CR	ADB
301B	CORRIDOR	3' - 0"	7' - 6"	WD-F	--	WD-1	HM-001	--	PT-5D	6B/A081	6A/A081	10B/A081	--	SH-2.1	--	X	CR	ADB
302A	MEN'S RESTROOM	3' - 0"	7' - 6"	HM-F	--	PT-2D	HM-001	--	PT-5D	6B/A081	6A/A081	9E/A081	--	HW-1	--	--	--	--
303A	RESTROOM	3' - 0"	7' - 6"	HM-F	--	PT-2D	HM-001	--	PT-5D	6B/A081	6A/A081	9E/A081	--	HW-2	--	--	--	--
304A	WOMEN'S RESTROOM	3' - 0"	7' - 6"	HM-F	--	PT-2D	HM-001	--	PT-5D	6B/A081	6A/A081	9E/A081	--	HW-1	--	--	--	--
306A	CUSTODIAL	3' - 0"	7' - 6"	HM-F	--	PT-2D	HM-001	--	PT-5D	6B/A081	6A/A081	9D/A081	--	HW-5	--	--	--	-- (2)
307A	IDF	4' - 0"	7' - 6"	HM-F	--	PT-2D	HM-001	--	PT-5D	6B/A081	6A/A081	9D/A081	--	SH-2A	--	X	CR	--
308A	CLASSROOM (011b)	3' - 0"	7' - 6"	WD-NV	GL-1	WD-1	HM-110A	GL-7(T) , GL-1	PT-5D	2B/A081	2A/A081	10B/A081	--	SH-2B.1	--	X	CR	ADB (013)
309A	STORAGE	3' - 0"	7' - 6"	HM-F	--	PT-2D	HM-001	--	PT-5D	6B/A081	6A/A081	9C/A081	--	SH-12	--	X	CR	
310A	ELEC. CLOSET	3' - 0"	7' - 6"	HM-F	--	PT-2D	HM-001	--	PT-5D	6B/A081	6A/A081	9D/A081 (4)	--	SH-5A	--	X	--	-- (2)
311A	CHEMISTRY LAB	3' - 0"	7' - 6"	WD-NV	GL-1	WD-1	HM-110A	GL-7(T) , GL-1	PT-5D	2B/A081	2A/A081	10B/A081	--	SH-2B	--	X	CR	ADB
311B (011b) (013)	CHEMISTRY LAB	4' - 6"	7' - 6"	WD-NV2	GL-1	WD-1	HM-100A	GL-1	PT-5D	2B/A081	6A/A081	--	--	SH-7	--	X	I/L 309A	UNEQUAL: 3'-0", 1'-6"; ADB
312A	PHYSICS LAB	3' - 0"	7' - 6"	WD-NV	GL-1	WD-1	HM-110A	GL-7(T) , GL-1	PT-5D	2B/A081	2A/A081	10B/A081	--	SH-2	--	X	CR	ADB
312B (013)	PHYSICS LAB	4' - 6"	7' - 6"	WD-NV2	GL-1	WD-1	HM-100A	GL-1	PT-5D	2B/A081	6A/A081	10B/A081	--	SH-7C.1	--	X	I/L 312A	ADB, UNEQUAL: 3'-0", 1'-6"
313A (011b)	WASTE	3' - 0"	7' - 6"	HM-F	--	PT-2D	HM-001	--	PT-5D	6B/A081	6A/A081	10B/A081	--	SH-2B.2	--	X	CR	--
314A	PHYSICS PREP & STORAGE	4' - 6"	7' - 6"	WD-NV2	GL-1 (011b)	WD-1	HM-100A	GL-1	PT-5D	2B/A081	6A/A081	--	--	SH-7B	--	X	CR	UNEQUAL: 3'-0", 1'-6"
314B	PHYSICS LAB	3' - 0"	7' - 6"	WD-NV	GL-1	WD-1	HM-001	--	PT-5D	6B/A081	6A/A081	--	--	SH-12	(011b)	--	CR (011b)	--
315A (011b)	CHEMISTRY PREP & STORAGE	3' - 0"	7' - 6"	WD-NV	GL-1 (013)	WD-1	HM-110A	GL-7(T) , GL-1	PT-5D	2B/A081	2A/A081	--	-- (013)	SH-2D	--	X	(013) CR	--
315B	CHEMISTRY PREP & STORAGE	3' - 0"	7' - 6"	WD-NV	GL-1	WD-1	HM-001	--	PT-5D	6B/A081	6A/A081	--	--	SH-12	(011b)	--	CR (011b)	--
315C	CHEMISTRY PREP & STORAGE	3' - 0"	7' - 6"	WD-NV	GL-1 (011b)	WD-1	HM-001	--	PT-5D	6B/A081	6A/A081	--	--	SH-12	--	--	CR	--
316A	CHEMISTRY LAB	3' - 0"	7' - 6"	WD-NV	GL-1	WD-1	HM-110A	GL-7(T) , GL-1	PT-5D	2B/A081	2A/A081	--	--	SH-2B	--	X	CR	--
316B	CHEMISTRY LAB	4' - 6"	7' - 6"	WD-NV2	GL-1	WD-1	HM-100A	GL-1	PT-5D	2B/A081	6A/A081	--	--	SH-7	--	X	I/L 316A	UNEQUAL: 3'-0", 1'-6"
317A (011b)	CHEMISTRY LAB	3' - 0"	7' - 6"	WD-NV	GL-1	WD-1	HM-110A	GL-7(T) , GL-1	PT-5D	2B/A081	2A/A081	--	--	SH-2B	--	X	CR	--
317B (013)	CHEMISTRY LAB	4' - 6"	7' - 6"	WD-NV2	GL-1	WD-1	HM-100A	GL-1	PT-5D	2B/A081	6A/A081	--	--	SH-7	--	X	I/L 315A	UNEQUAL: 3'-0", 1'-6"
318A	CHEMISTRY PREP & STORAGE	4' - 6"	7' - 6"	WD-NV2	GL-1 (011b)	WD-1	HM-100A	GL-1	PT-5D	2B/A081	6A/A081

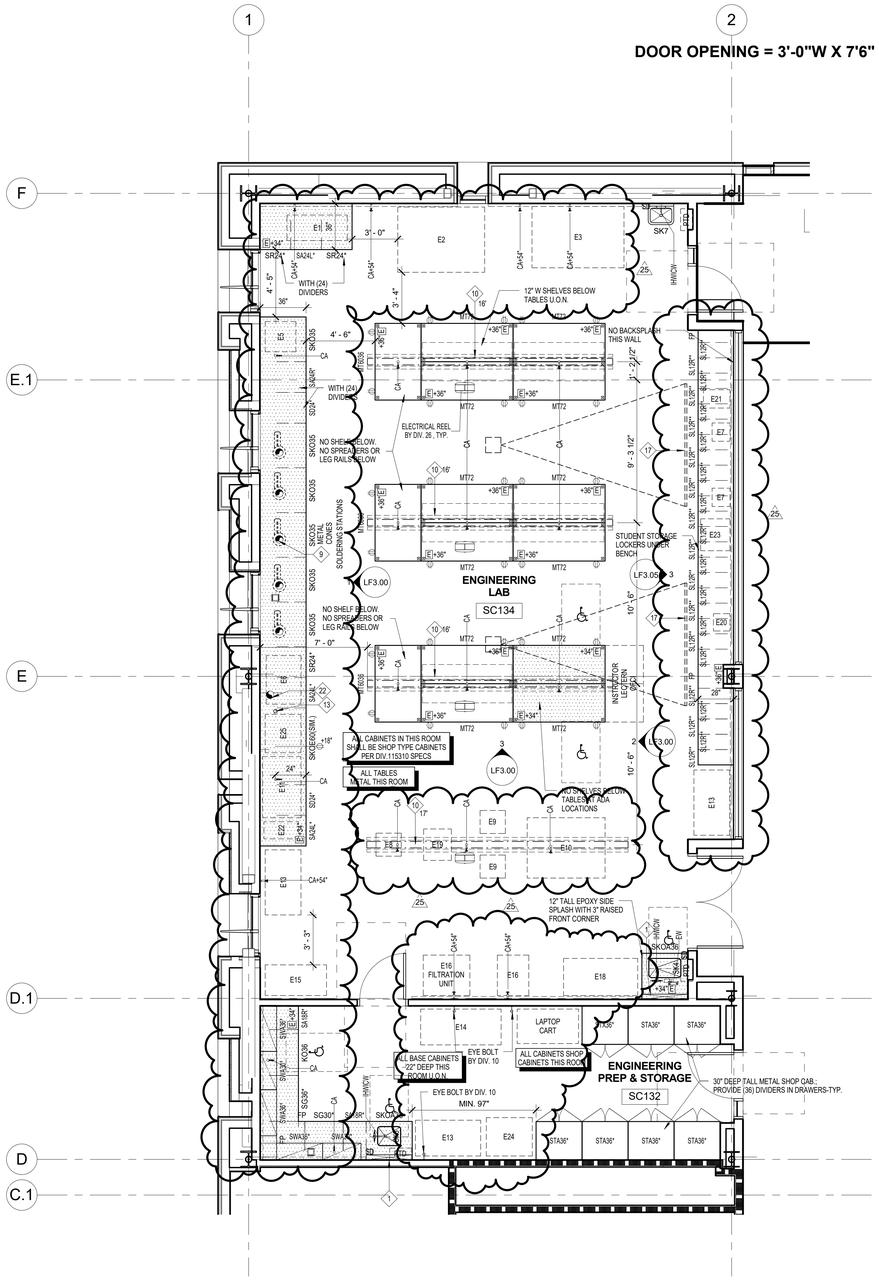

1 FIRST LEVEL PARTIAL PLAN
1/4" = 1'-0"

ALL LOCKABLE CABINETS IN EACH ROOM SHALL BE KEYED ALIKE W/ MASTER KEY SYSTEM - (NO KEY LOCKS AT PAD LOCK HASP LOCATIONS) - TYP AT ALL FLOORS

HGA
1918 Main Street, Third Floor
Santa Monica , California 90405
Telephone 310.557.7600

STRUCTURAL ENGINEER
SAIFUL BOUQUET
155 N LAKE AVE
PASADENA, CA 91101
626-304-2616

MECHANICAL & PLUMBING ENGINEER
STANTEC CONSULTING INC
14130 RIVERSIDE DR. # 201
SHERMAN OAKS, CA 91423
818-377-8220

ELECTRICAL ENGINEER
FBA ENGINEERING
150 PAULARINO AVE. #A120
COSTA MESA, CA 92626
949-852-9995

CIVIL ENGINEER
KPFF CONSULTING ENGINEERS
700 SOUTH FLOWER ST. #2100
LOS ANGELES, CA 90017
213-418-0201

LANDSCAPE ARCHITECT
LYNN CAPOUYA, INC.
17992 MITCHELL SOUTH, #110
IRVINE, CA 92614
949-756-0150

LABORATORY CONSULTANT
RESEARCH FACILITIES DESIGN
3965 FIFTH AVE. #400
SAN DIEGO, CA 92103
619-297-0159

SCIENCE CENTER
SANTA ANA COLLEGE

RANCHO SANTIAGO COMMUNITY COLLEGE DISTRICT

1530 W. 17TH ST.
SANTA ANA, CA 92706

SANTA ANA COLLEGE

I HEREBY CERTIFY THAT THIS PLAN, SPECIFICATION OR REPORT WAS PREPARED BY ME OR UNDER MY DIRECT SUPERVISION AND THAT I AM A DULY LICENSED ARCHITECT UNDER THE LAWS OF THE STATE OF CA.

LICENSED ARCHITECT KEVIN DONAGHEY No. C34799 Exp. 12/31/19 STATE OF CALIFORNIA

LICENSED ARCHITECT BEN TIMMONS No. C34749 Exp. 9/30/2019 STATE OF CALIFORNIA

NAME: KEVIN DONAGHEY
DATE: SEPTEMBER 30, 2019
REGISTRATION NUMBER: C34799

APPROVED
DIVISION OF THE STATE ARCHITECT

ACS MP FLS JA SSR CNg

A# 04- 115788 DATE: 09.11.18

NO	DESCRIPTION	DATE
2	Addendum 2	09/01/17
25	CCD-A-025	08/29/18

ISSUANCE HISTORY - THIS SHEET

DRAWN BY: Author | REVIEW BY: Approver

HGA NO: 3584-001-00

FIRST LEVEL PARTIAL PLAN

DATE: JULY 06, 2017

LF2.01A

© COPYRIGHT HAMMEL, GREEN AND ABRAHAMSON, INC.

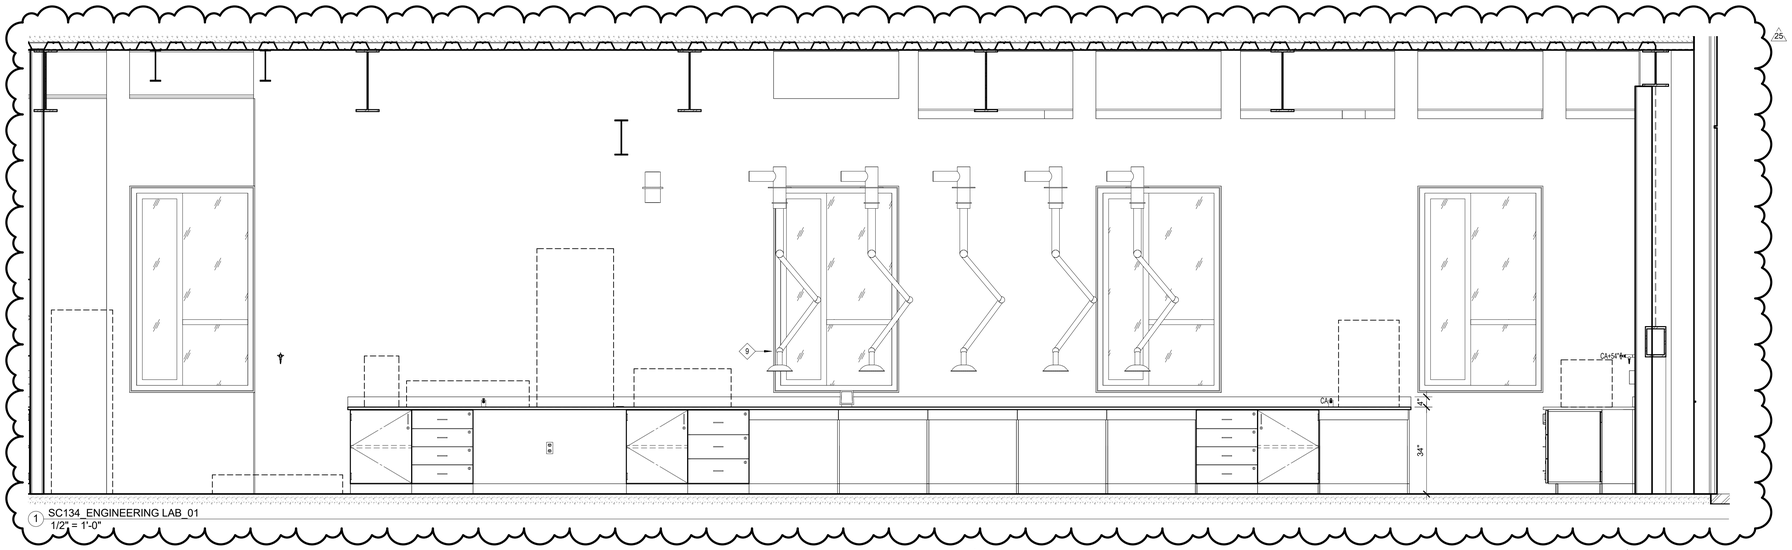

1 SC134_ENGINEERING LAB_01
1/2" = 1'-0"

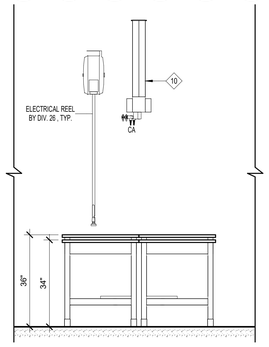

2 SC134_ENGINEERING LAB_02B
1/2" = 1'-0"

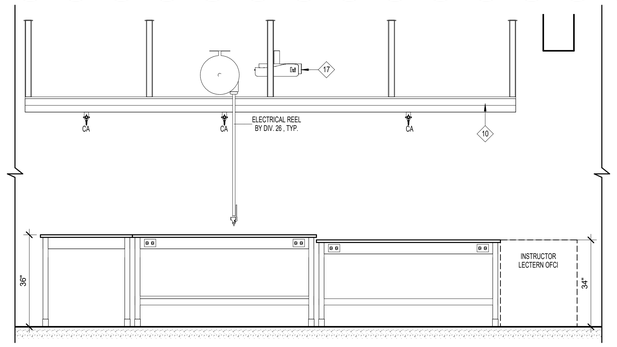

3 SC134_ENGINEERING LAB_02A
1/2" = 1'-0"

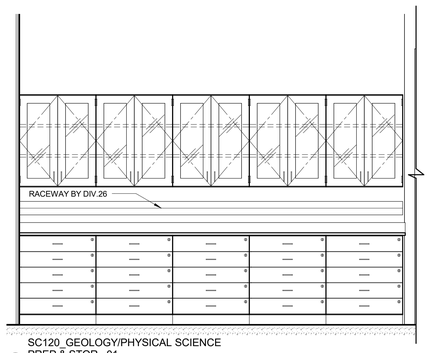

4 SC120_GEOLOGY/PHYSICAL SCIENCE
PREP & STOR._01
1/2" = 1'-0"

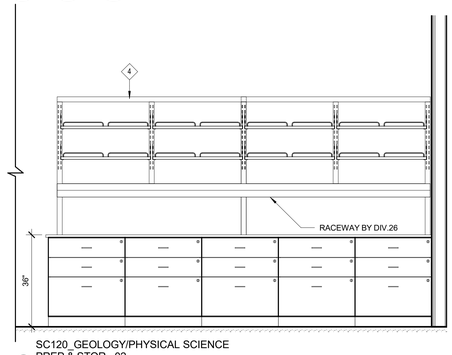

5 SC120_GEOLOGY/PHYSICAL SCIENCE
PREP & STOR._02
1/2" = 1'-0"

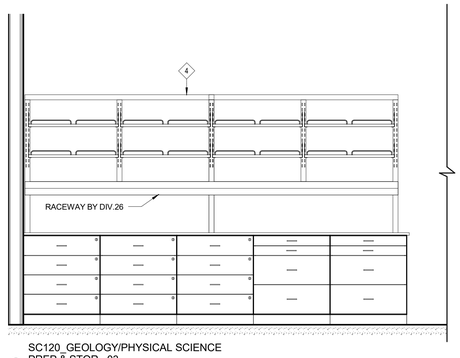

6 SC120_GEOLOGY/PHYSICAL SCIENCE
PREP & STOR._03
1/2" = 1'-0"

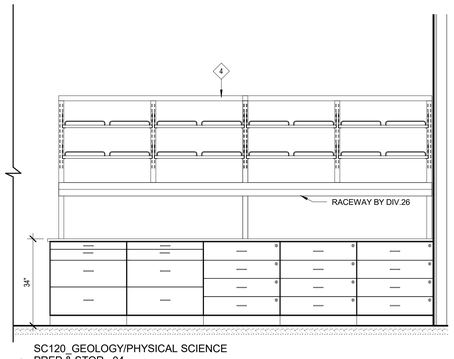

7 SC120_GEOLOGY/PHYSICAL SCIENCE
PREP & STOR._04
1/2" = 1'-0"

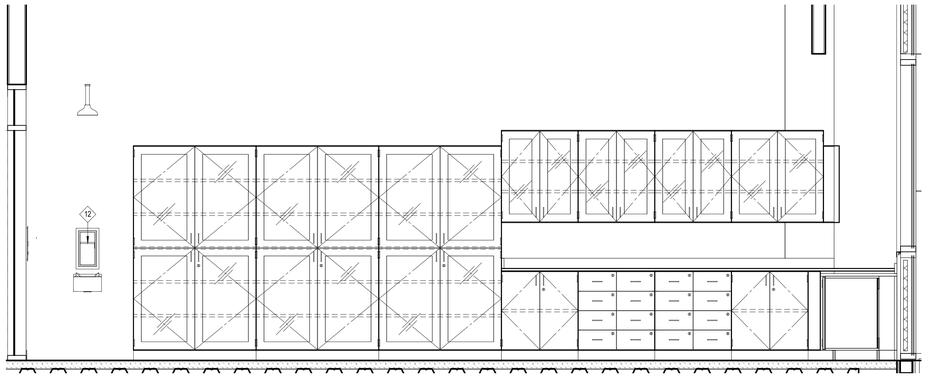

8 SC212_MOLECULAR BIOLOGY LAB_01
1/2" = 1'-0"

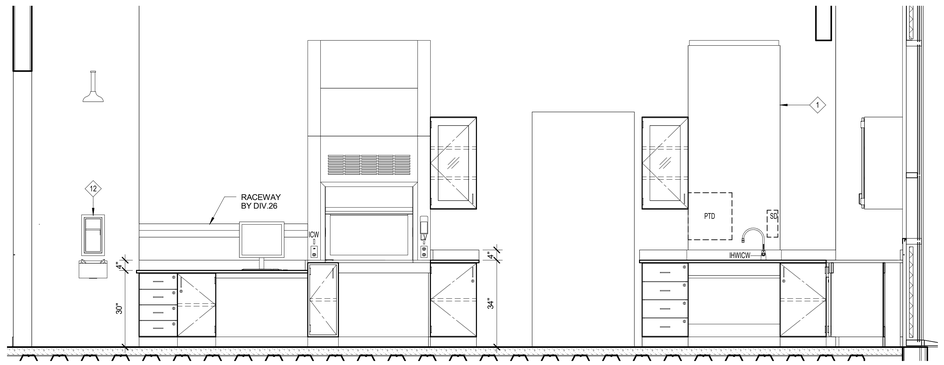

9 SC213_PHYSIOLOGY LAB_01
1/2" = 1'-0"

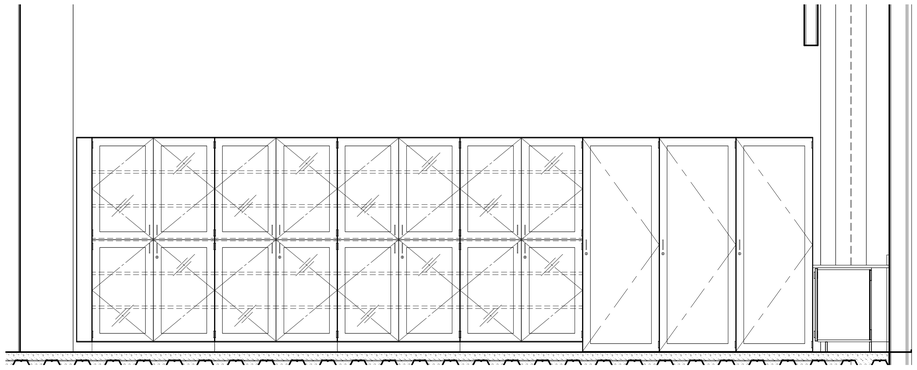

10 SC217_ANATOMY LAB_01
1/2" = 1'-0"

HGA
1918 Main Street, Third Floor
Santa Monica , California 90405
Telephone 310.557.7600

STRUCTURAL ENGINEER
SAIFUL BOUQUET
155 N LAKE AVE
PASADENA, CA 91101
626-304-2616

MECHANICAL & PLUMBING ENGINEER
STANTEC CONSULTING INC
14130 RIVERSIDE DR. # 201
SHERMAN OAKS, CA 91423
818-377-8220

ELECTRICAL ENGINEER
FBA ENGINEERING
150 PAULARINO AVE. #A120
COSTA MESA, CA 92626
949-852-9995

CIVIL ENGINEER
KPFF CONSULTING ENGINEERS
700 SOUTH FLOWER ST. #2100
LOS ANGELES, CA 90017
213-418-0201

LANDSCAPE ARCHITECT
LYNN CAPOUYA, INC.
17992 MITCHELL SOUTH, #110
IRVINE, CA 92614
949-756-0150

LABORATORY CONSULTANT
RESEARCH FACILITIES DESIGN
3965 FIFTH AVE. #400
SAN DIEGO, CA 92103
619-297-0159

SCIENCE CENTER
SANTA ANA COLLEGE

RANCHO SANTIAGO
COMMUNITY COLLEGE
DISTRICT

1530 W. 17TH ST.
SANTA ANA, CA 92706

SANTA ANA
COLLEGE

I HEREBY CERTIFY THAT THIS PLAN, SPECIFICATION OR REPORT WAS PREPARED BY ME OR UNDER MY DIRECT SUPERVISION AND THAT I AM A DULY LICENSED ARCHITECT UNDER THE LAWS OF THE STATE OF CALIFORNIA

LICENSED ARCHITECT KEVIN DONAGHEY No. C34799 Exp. 12/31/19 STATE OF CALIFORNIA

LICENSED ARCHITECT JEAN TOMASSIAN No. C34799 Exp. 12/31/19 STATE OF CALIFORNIA

NAME: KEVIN DONAGHEY
DATE: SEPTEMBER 30, 2019
REGISTRATION NUMBER: C34799

APPROVED
DIVISION OF THE STATE ARCHITECT

ACS MP FLS JA SSR CNg

A# 04-115788 DATE: 09.11.18

NO	DESCRIPTION	DATE
3	Addendum 3	09/22/17
25	CCD-A-025	08/29/18

ISSUANCE HISTORY - THIS SHEET

DRAWN BY: Author | REVIEW BY: Approver

HGA NO: 3584-001-00

ELEVATIONS

DATE: JULY 06, 2017

LF3.00

© COPYRIGHT HAMMEL, GREEN AND ABRAHAMSON, INC.

Author 9/10/2018 5:03:47 PM C:\Users\mrisci\Documents\LF-CENTRAL-SAC-2018_mrisci@hd.com.rvt

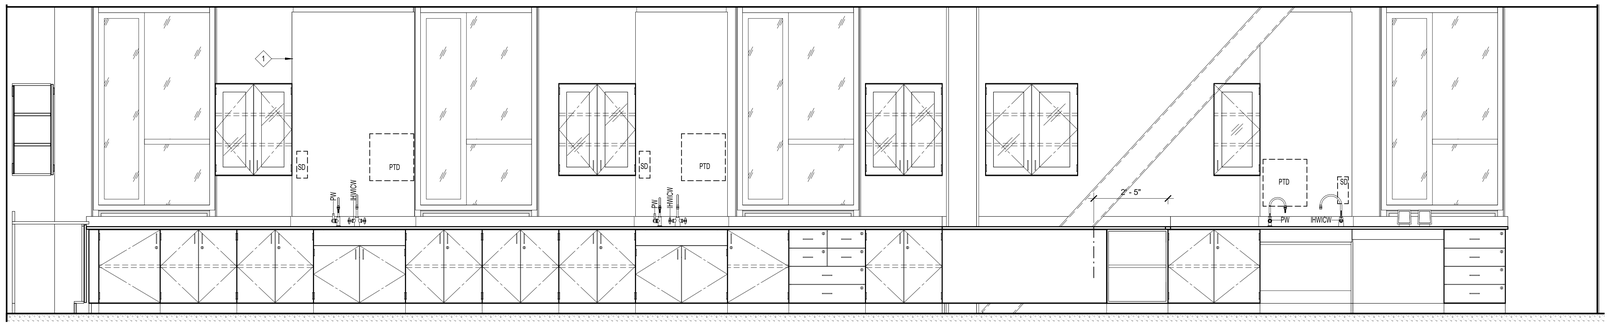

1 SC212_MOLECULAR BIOLOGY LAB_02
1/2" = 1'-0"

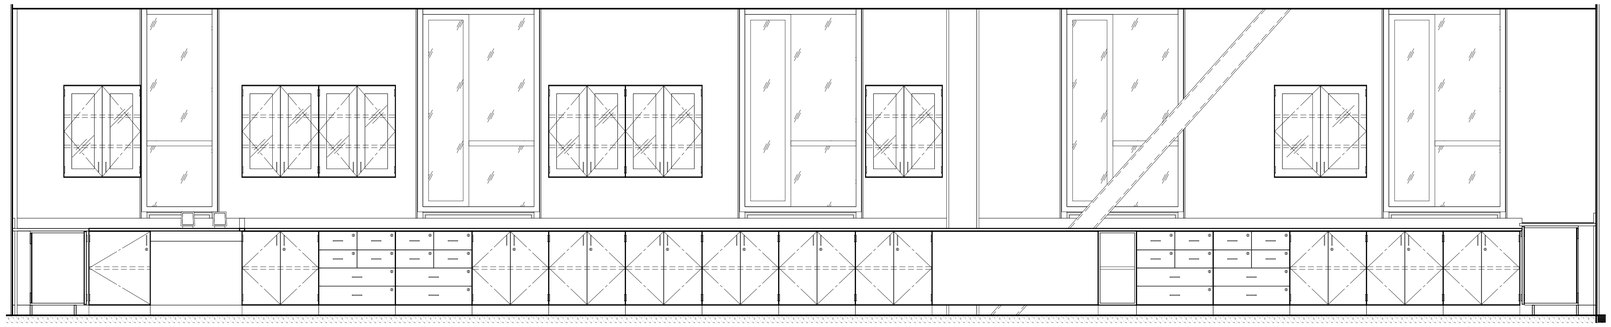

2 SC213_PHYSIOLOGY LAB_02
1/2" = 1'-0"

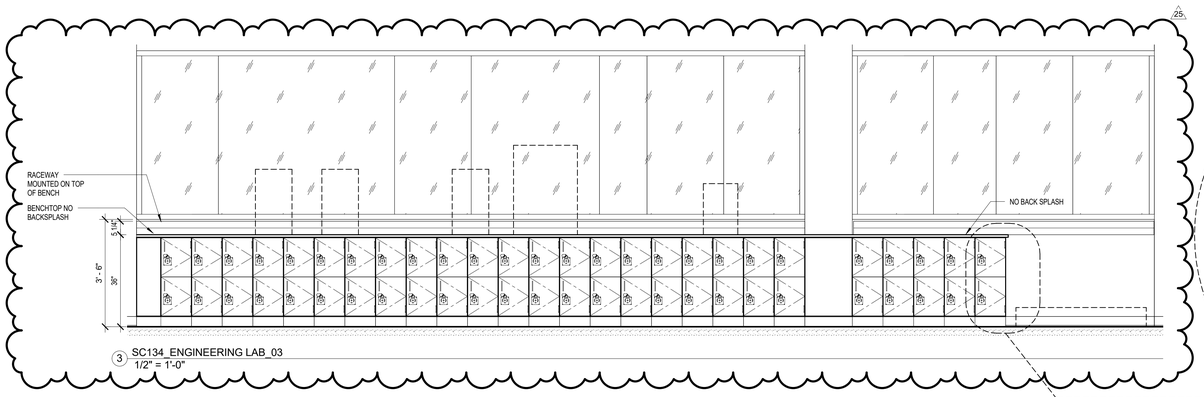

3 SC134_ENGINEERING LAB_03
1/2" = 1'-0"

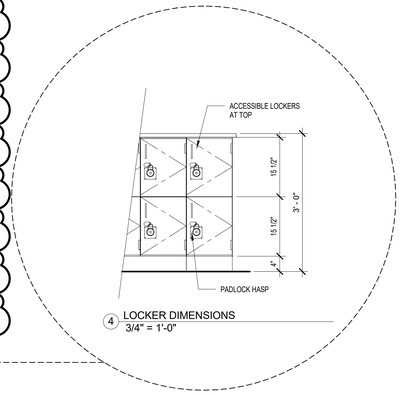

4 LOCKER DIMENSIONS
3/4" = 1'-0"

HGA
1918 Main Street, Third Floor
Santa Monica , California 90405
Telephone 310.557.7600

STRUCTURAL ENGINEER
SAIFUL BOUQUET
155 N LAKE AVE
PASADENA, CA 91101
626-304-2616

MECHANICAL & PLUMBING ENGINEER
STANTEC CONSULTING INC
14130 RIVERSIDE DR. # 201
SHERMAN OAKS, CA 91423
818-377-8220

ELECTRICAL ENGINEER
FBA ENGINEERING
150 PAULARINO AVE. #A120
COSTA MESA, CA 92626
949-852-9995

CIVIL ENGINEER
KPFF CONSULTING ENGINEERS
700 SOUTH FLOWER ST. #2100
LOS ANGELES, CA 90017
213-418-0201

LANDSCAPE ARCHITECT
LYNN CAPOUYA, INC.
17992 MITCHELL SOUTH, #110
IRVINE, CA 92614
949-756-0150

LABORATORY CONSULTANT
RESEARCH FACILITIES DESIGN
3965 FIFTH AVE. #400
SAN DIEGO, CA 92103
619-297-0159

SCIENCE CENTER
SANTA ANA COLLEGE

RANCHO SANTIAGO COMMUNITY COLLEGE DISTRICT

1530 W. 17TH ST.
SANTA ANA, CA 92706

SANTA ANA COLLEGE

I HEREBY CERTIFY THAT THIS PLAN, SPECIFICATION OR REPORT WAS PREPARED BY ME OR UNDER MY DIRECT SUPERVISION AND THAT I AM A DULY LICENSED ARCHITECT UNDER THE LAWS OF THE STATE OF CA.

REGISTERED ARCHITECT KEVIN DONAGHEY REG. NO. C34799 EXP. 9-30-2019 STATE OF CALIFORNIA

LICENSED ARCHITECT KEVIN DONAGHEY REG. NO. C34799 EXP. 9-30-2019 STATE OF CALIFORNIA

NAME: KEVIN DONAGHEY
DATE: SEPTEMBER 30, 2019
REGISTRATION NUMBER: C34799

APPROVED
DIVISION OF THE STATE ARCHITECT

ACS MP FLS JA SSR CNg

A# 04- 115788 DATE: 09.11.18

NO	DESCRIPTION	DATE
25	CCD-A-025	08/29/18

ISSUANCE HISTORY - THIS SHEET

DRAWN BY: Author | REVIEW BY: Approver

HGA NO: 3584-001-00

ELEVATIONS

DATE: JULY 06, 2017

LF3.05

© COPYRIGHT HAMMEL, GREEN AND ABRAHAMSON, INC.

Author 9/10/2018 5:03:56 PM C:\Users\mrisso\Documents\LF-CENTRAL-SAC-2018_mrisso@hd.com.rvt

FIXTURE CONNECTION SCHEDULE

PIPE SIZE IN INCHES									
FIXTURE/FITTING NO.	TW@DH	ICW	IHW	PW	LG	LV	CA	LW(P-TRAP)	LW(SED. TRAP)
SKA	1/2	1/2	1/2					1 1/2	
SKB		1/2	1/2					1 1/2	
SKC		1/2	1/2	1/2				1 1/2	
SKD		1/2	1/2						
SKE		1/2	1/2	1/2					
SKF		1/2	1/2						1 1/2
CSA								1 1/2	

NOTES:
1. BUILDING PW WATER LOOP TO EACH FIXTURE PER LP-SERIES DRAWINGS.
2. CONNECTION TO SERVICE PER LP-SERIES DRAWINGS.
3. ALL SERVICES TO FUME HOOD TO BE PRE-PIPED TO SINGLE POINT OF CONNECTION BY DIV. 11. FUME HOOD SERVICE FITTING LOCATION MAY VARY, REFER TO LF PLANS.

SERVICE FITTING SCHEDULE

PIPE SIZE IN INCHES							
SERVICE FITTING NO.	TW	ICW	IHW	PW	LG	LV	CA
SF1	1 1/4						
SF2							1/2
SF3						3/4	
SF4					1/2		
SF5					1/2	3/4	
SF6		1/2					
SF7		3/4	3/4				
SF8				1/2			

EQUIPMENT CONNECTION SCHEDULE

PIPE SIZE IN INCHES							
EQUIPMENT NO.	ICW	IHW	PW	SW	LG	LV	CA
EQ1(ICE MACHINE)	1/2						
EQ2(WATER SOFTENER)	1/2						
EQ3(AUTOCLAVE, 20x20x38)	1			1/2			1/2

NOTES:
1. BUILDING PW WATER LOOP TO EACH EQUIPMENT PER LP-SERIES DRAWINGS.
2. CONNECTION TO SERVICE PER LP-SERIES DRAWINGS.

SERVICE DROP SCHEDULE

PIPE SIZE IN INCHES								
DROP NUMBER NO.	TW	ICW	IHW	PW	LG	LV	CA	IHWR
1							1/2	
2	3/4	1/2	1/2				25	
3		1/2	1/2					
4		3/4	3/4	*				
5		3/4	3/4					
6		1/2	1/2				1/2	
7		1/2			1/2			
8		3/4	3/4		1 1/4	2		
9					3/4	1 1/4		
10					1/2	3/4		
11		1/2				3/4		
12		1	1					
13		1	3/4	*			1/2	
14		1/2			1/2	3/4		
15		1/2	1/2	*	1	2		
16					1/2	1		
17		1/2	1/2		1 1/4	2		
18					1 1/4	2		
19		1/2	1/2	*	1 1/4	2		
20					1/2			
21		1	1	*				1/2
~~22~~		~~3/4~~	~~3/4~~	~~1/2~~				
23		3/4	1					

25

* BUILDING PW WATER SIZE

NOTES:
1. BUILDING PW WATER LOOP TO EACH SERVICE DROP PER LP-SERIES DRAWINGS.

PIPING POINT OF CONNECTION SCHEDULE

ROOM NAME	ROOM NO.	POC NO.		TW GPM	ICW GPM	IHW GPM	IHWR GPM	PW GPM	LG sCFH	LV sCFM	CA sCFM
FIRST LEVEL											
ENGINEERING LAB	SC134	1.01	DESIGN FLOW	3	3	3					60
			PIPE SIZE (IN)	3/4	3/4	3/4	1/2				1
ENGINEERING PREP & STORAGE	SC132	1.02	DESIGN FLOW		1.5	1.5					5
			PIPE SIZE (IN)		1/2	1/2	1/2				1/2
GEOLOGY / PHYSICAL SCIENCE LAB & LECTURE	SC122	1.03	DESIGN FLOW	23	3	3					
			PIPE SIZE (IN)	1 1/4	3/4	3/4	1/2				
GEOLOGY / PHYSICAL SCIENCE PREP & STORAGE	SC120	1.04	DESIGN FLOW		1.5	1.5					
			PIPE SIZE (IN)		1/2	1/2	1/2				
GEOLOGY / EARTH SCIENCE LAB	SC118	1.05	DESIGN FLOW	23	4	4					
			PIPE SIZE (IN)	1 1/4	3/4	3/4	1/2				
SECOND LEVEL											
ORGANISMAL BIOLOGY LAB	SC226	2.01	DESIGN FLOW	23	4	4		1			
			PIPE SIZE (IN)	1 1/4	3/4	3/4	1/2	*			
ANATOMY LAB / CADAVER ROOM	SC217 / SC217-1	2.02	DESIGN FLOW	23	7	7					
			PIPE SIZE (IN)	1 1/4	1	1	1/2				
GENERAL & ORGANISMAL PREP & STORAGE	SC220	2.03	DESIGN FLOW	23	3	3		2	4		
			PIPE SIZE (IN)	1 1/4	3/4	3/4	1/2	*	1/2		
GENERAL BIOLOGY LAB	SC218	2.04	DESIGN FLOW	23	5	5					
			PIPE SIZE (IN)	1 1/4	3/4	3/4	1/2				
ANATOMY & PHYSIOLOGY PREP & STORAGE	SC215	2.05	DESIGN FLOW	23	2	1.5			4		
			PIPE SIZE (IN)	1 1/4	1/2	1/2	1/2		1/2		
MICROBIOLOGY	SC216	2.06	DESIGN FLOW	23	11	10			116	22	
			PIPE SIZE (IN)	1 1/4	1	1	1/2		1 1/4	2	
PHYSIOLOGY LAB	SC213	2.07	DESIGN FLOW	23	9	8				1	
			PIPE SIZE (IN)	1 1/4	1	1	1/2			3/4	
MOLECULAR BIOLOGY PREP & STORAGE	SC214	2.08	DESIGN FLOW	23	11	6		3	4	2	
			PIPE SIZE (IN)	1 1/4	1	3/4	1/2	*	1/2	3/4	
MOLECULAR BIOLOGY LAB	SC212	2.09	DESIGN FLOW	23	4	4		3	64	18	
			PIPE SIZE (IN)	1 1/4	3/4	3/4	1/2	*	1	2	
THIRD LEVEL											
CHEMISTRY LAB	SC326	3.01	DESIGN FLOW	23	7	4		3	112	32	
			PIPE SIZE (IN)	1 1/4	1	3/4	1/2	*	1 1/4	2 1/2	
CHEMISTRY LAB	SC315	3.02	DESIGN FLOW	23	7	4		3	112	32	
			PIPE SIZE (IN)	1 1/4	1	3/4	1/2	*	1 1/4	2 1/2	
CENTRALIZED PREP & STORAGE	SC322	3.03	DESIGN FLOW	23	7	7		3	12	2	
			PIPE SIZE (IN)	1 1/4	1	1	1/2	*	1/2	3/4	
ORGANIC CHEMISTRY LAB	SC320	3.04	DESIGN FLOW	23	27	7		6	92	24	
			PIPE SIZE (IN)	1 1/4	1 1/4	1	1/2	*	1 1/4	2	
CHEMISTRY PREP & STORAGE	SC318	3.05	DESIGN FLOW	23	1.5	1.5			4	1	
			PIPE SIZE (IN)	1 1/4	1/2	1/2	1/2		1/2	3/4	
CHEMISTRY LAB	SC316	3.06	DESIGN FLOW	23	7	4		3	112	32	
			PIPE SIZE (IN)	1 1/4	1	3/4	1/2	*	1 1/4	2 1/2	
CHEMISTRY PREP & STORAGE	SC313	3.07	DESIGN FLOW	23	3	3		1	8	2	
			PIPE SIZE (IN)	1 1/4	3/4	3/4	1/2	*	1/2	3/4	
CHEMISTRY LAB	SC309	3.08	DESIGN FLOW	23	7	4		3	112	32	
			PIPE SIZE (IN)	1 1/4	1	3/4	1/2	*	1 1/4	2 1/2	
PHYSICS PREP & STORAGE	SC314	3.09	DESIGN FLOW		1.5	1.5					
			PIPE SIZE (IN)		1/2	1/2	1/2				
PHYSICS LAB	SC312	3.10	DESIGN FLOW		1.5	1.5					35
			PIPE SIZE (IN)		1/2	1/2	1/2				1/2

NOTES:
1. FLOW RATES REPRESENT DESIGN PEAK LABORATORY LOADS USED FOR PIPE SIZING AT POC.
2. TW- TEPID WATER FOR SAFETY SHOWER/EYEWASH SIZED FOR INSTANTANEOUS/INCIDENTAL USE.
3. * PROVIDE MINIMUM 3 fps CIRCULATION VELOCITY IN LABORATORY PW LOOP. SYSTEM STATIC PRESSURE SHOULD NOT EXCEED 60 psig. VALVED SERVICE CONNECTION PER LP SCHEDULES AND DETAILS.
4. COMPRESSED AIR DISTRIBUTED AT 100 psig TO LABORATORY POC. PROVIDE PRESSURE REGULATORS AS SHOWN ON PLANS FOR LOWER PRESSURE SERVICES.
5. IHWR CIRCULATED INSIDE LABORATORY AS SHOWN ON PLANS. DESIGN FLOW PER P-SERIES DRAWINGS.

ESTIMATED PW WATER CONSUMPTION AND PEAK LOAD		
	GAL	GPM
PW WATER HOURLY CONSUMPTION	60	
PW WATER 4-HOUR CONSUMPTION	240	
PW WATER PEAK FLOW RATE		10

HGA
1918 Main Street, Third Floor
Santa Monica, California 90405
Telephone 310.557.7600

STRUCTURAL ENGINEER
SAIFUL BOUQUET
155 N LAKE AVE
PASADENA, CA 91101
626-304-2616

MECHANICAL & PLUMBING ENGINEER
STANTEC CONSULTING INC
14130 RIVERSIDE DR. # 201
SHERMAN OAKS, CA 91423
818-377-8220

ELECTRICAL ENGINEER
FBA ENGINEERING
150 PAULARINO AVE. #A120
COSTA MESA, CA 92626
949-852-9995

CIVIL ENGINEER
KPFF CONSULTING ENGINEERS
700 SOUTH FLOWER ST. #2100
LOS ANGELES, CA 90017
213-418-0201

LANDSCAPE ARCHITECT
LYNN CAPOUYA, INC.
17992 MITCHELL SOUTH, #110
IRVINE, CA 92614
949-756-0150

LABORATORY CONSULTANT
RESEARCH FACILITIES DESIGN
3965 FIFTH AVE. #400
SAN DIEGO, CA 92103
619-297-0159

SCIENCE CENTER
SANTA ANA COLLEGE
RANCHO SANTIAGO COMMUNITY COLLEGE DISTRICT
1530 W. 17TH ST.
SANTA ANA, CA 92706

SANTA ANA COLLEGE

I HEREBY CERTIFY THAT THIS PLAN, SPECIFICATION OR REPORT WAS PREPARED BY ME OR UNDER MY DIRECT SUPERVISION AND THAT I AM A DULY LICENSED ARCHITECT UNDER THE LAWS OF THE STATE OF CA.

LICENSED ARCHITECT KEVIN DONAGHEY No. C34798 STATE OF CALIFORNIA

REGISTERED PROFESSIONAL ENGINEER A. BROOKS STOUT M35475 EXP. 6/30/19 MECHANICAL STATE OF CALIFORNIA

NAME: KEVIN DONAGHEY — A. BROOKS STOUT
DATE: SEPTEMBER 30, 2019 — JUNE 30, 2019
REGISTRATION NUMBER: C34798 — M35475

APPROVED
DIVISION OF THE STATE ARCHITECT

ACS MP FLS JA SSR CNg

A# 04- 115788 DATE: 09.11.18

NO	DESCRIPTION	DATE
25	CCD-A-025	08/29/18

ISSUANCE HISTORY - THIS SHEET

DRAWN BY: RI — REVIEW BY: PL

HGA NO: 3584-001-00

LABORATORY PLUMBING SCHEDULES

DATE: JULY 06, 2017

LP1.01

© COPYRIGHT HAMMEL, GREEN AND ABRAHAMSON, INC.

RI 8/28/2018 9:20:58 AM N:\2014\1-2014049\REVIT\LP\LP-SAC-2018.rvt

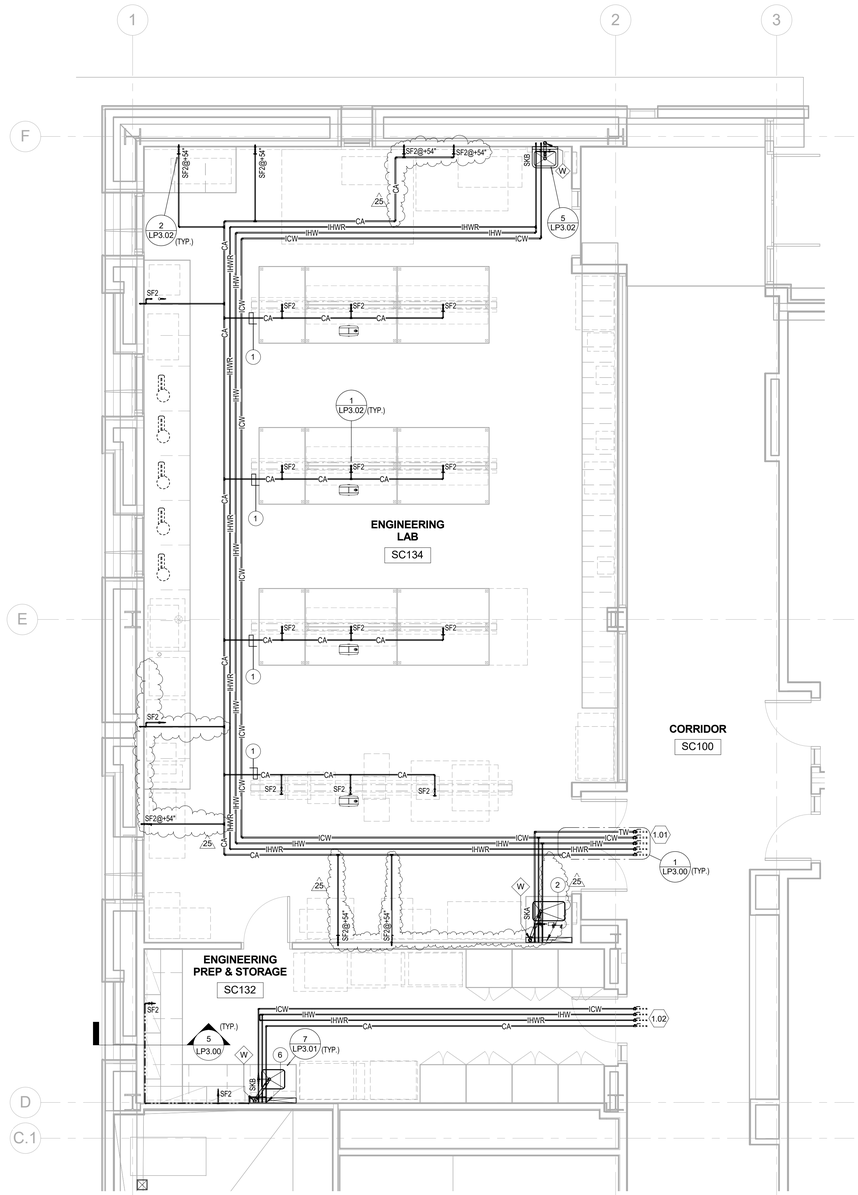

1 FIRST LEVEL PARTIAL PLAN
1/4" = 1'-0"

HGA
1918 Main Street, Third Floor
Santa Monica , California 90405
Telephone 310.557.7600

STRUCTURAL ENGINEER
SAIFUL BOUQUET
155 N LAKE AVE
PASADENA, CA 91101
626-304-2616

MECHANICAL & PLUMBING ENGINEER
STANTEC CONSULTING INC
14130 RIVERSIDE DR. # 201
SHERMAN OAKS, CA 91423
818-377-8220

ELECTRICAL ENGINEER
FBA ENGINEERING
150 PAULARINO AVE. #A120
COSTA MESA, CA 92626
949-852-9995

CIVIL ENGINEER
KPFF CONSULTING ENGINEERS
700 SOUTH FLOWER ST. #2100
LOS ANGELES, CA 90017
213-418-0201

LANDSCAPE ARCHITECT
LYNN CAPOUYA, INC.
17992 MITCHELL SOUTH, #110
IRVINE, CA 92614
949-756-0150

LABORATORY CONSULTANT
RESEARCH FACILITIES DESIGN
3965 FIFTH AVE. #400
SAN DIEGO, CA 92103
619-297-0159

SCIENCE CENTER
SANTA ANA COLLEGE

RANCHO SANTIAGO COMMUNITY COLLEGE DISTRICT

1530 W. 17TH ST.
SANTA ANA, CA 92706

SANTA ANA COLLEGE

I HEREBY CERTIFY THAT THIS PLAN, SPECIFICATION OR REPORT WAS PREPARED BY ME OR UNDER MY DIRECT SUPERVISION AND THAT I AM A DULY LICENSED ARCHITECT UNDER THE LAWS OF THE STATE OF CA.

LICENSED ARCHITECT KEVIN DONAGHEY No. C34799 STATE OF CALIFORNIA

REGISTERED PROFESSIONAL ENGINEER A. BROOKS STOUT M35475 Exp. 6/30/19 MECHANICAL STATE OF CALIFORNIA

NAME: KEVIN DONAGHEY — A. BROOKS STOUT
DATE: SEPTEMBER 30, 2019 — JUNE 30, 2019
REGISTRATION NUMBER: C34799 — M35475

APPROVED
DIVISION OF THE STATE ARCHITECT

ACS MP FLS JA SSR CNg

A# 04- 115788 DATE: 09.11.18

NO	DESCRIPTION	DATE
25	CCD-A-025	08/29/18

ISSUANCE HISTORY - THIS SHEET

DRAWN BY: RI — REVIEW BY: PL

HGA NO: 3584-001-00

LABORATORY PLUMBING FIRST LEVEL PATIAL PLAN

DATE: JULY 06, 2017

0' 2' 4' 8'

LP2.01A

© COPYRIGHT HAMMEL, GREEN AND ABRAHAMSON, INC.

RI 8/29/2018 9:20:59 AM N:\2014\1-2014\04\REVITL\PLP-SAC-2016.rvt

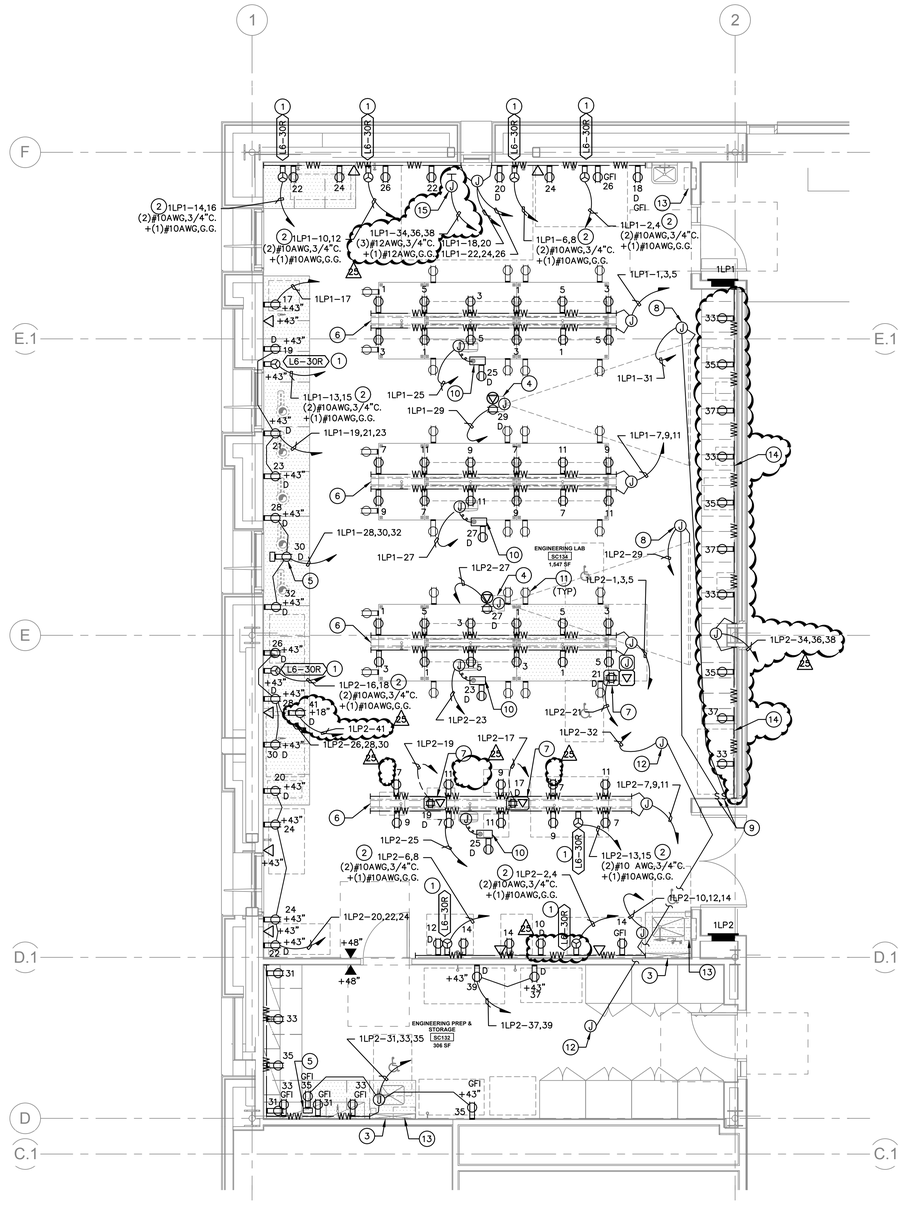

KEY NOTES:

1. MOUNT RECEPTACLE IN WIREWAY.
2. ROUTE HOMERUN THROUGH WIREWAY.
3. PIPEDROP, UTILIZE FOR CONCEALMENT OF CONDUIT. SEE DETAIL 6/LE4.01 AND 1/LE4.02.
4. CEILING MOUNT PROJECTOR. PROVIDE RECEPTACLE. VERIFY LOCATION AND MOUNTING WTH AV SERIES DRAWINGS AND SPECIFICATIONS.
5. ELECTRICAL PEDESTAL, SEE DETAIL 2/LE4.02.
6. OVERHEAD SERVICE CARRIER. SEE DETAIL 1/LE4.01.
7. PROVIDE AND INSTALL RECESSED FLOORBOX SUITABLE FOR SLAB ON GRADE INSTALLATION. WIREMOLD RFB4 SERIES.
8. J-BOX FOR MOTORIZED PROJECTION SCREEN. PROVIDE CONNECTION, VERIFY REQUIREMENTS.
9. PROVIDE AND INSTALL UP-DOWN SWITCH FOR PROJECTION SCREEN. COORDINATE WITH MANUFACTURER AND PROVIDE CONNECTION. PROVIDE AND INSTALL POWER CORD REEL.
10. COXREELS EZ-PC13-2512-F OR EQUAL WITH DUPLEX G.F.C.I. METAL INDUSTRIAL RECEPTACLE AND 25 CORD FEET, UNLESS OTHERWISE SPECIFIED IN LABORATORY FURNISHINGS DESIGN. COORDINATE LOCATION WITH LABORATORY FURNISHING DRAWINGS. INSTALL PER MANUFACTURER'S RECOMMENDATIONS.
11. PROVIDE AND INSTALL J-BOX AND RECEPTACLE TO MOVEABLE TABLE. PROVIDE AND INSTALL S.O. CORD (10'MIN.) AND PLUG (5-20P). SEE DETAIL 3/LE4.02.
12. PROVIDE J-BOX AND 120V CIRCUIT FOR PAPER TOWEL DISPENSERS. REQUIRED 6V DC POWER SUPPLY BY OTHERS. CONTRACTOR SHALL PROVIDE CONDUIT FROM J-BOX TO PAPER TOWEL DISPENSER LOCATIONS. SEE KEYNOTE 13 FOR PAPER TOWEL DISPENSER LOCATIONS.
13. LOCATION OF PAPER TOWEL DISPENSER. SEE KEYNOTE 12 FOR ADDITIONAL INFORMATION.
14. RACEWAY AT THIS LOCATION MOUNTED ON WALL ABOVE BENCH AT +38"A.F.F. TO BOTTOM OF RACEWAY.
15. PROVIDE J-BOX AND CIRCUITS FOR COMPACT MILL PER MANUFACTURER'S RECOMMENDATIONS. COORDINATE WITH MANUFACTURER AND PROVIDE CONNECTION.

GENERAL NOTES:

1. COORDINATE ALL DEVICE MOUNTING HEIGHTS AND LOCATIONS WITH LABORATORY FURNISHING DESIGN PRIOR TO ROUGH-IN.
2. AT ISLAND BENCHES WITHOUT PIPEDROP STUB ELECTRICAL FROM BELOW FLOOR UP INTO PIPE CHASE. SEE LABORATORY FURNISHINGS DETAIL FOR LOCATION AND DIMENSIONS OF PIPE CHASE.
3. ALL OUTLETS WITHIN 6'-0" OF SINK TO BE GFI.
4. PROVIDE (1) 1-1/4" C.O. STUBBED FROM EACH WALL, FLOOR, OR WIREWAY MOUNTED TELE/DATA OUTLET TO ACCESSIBLE CEILING.
5. PROVIDE A MINIMUM OF (1) 1-1/4" C.O. STUBBED FROM EACH TELE/DATA SECTION OF DUAL CHANNEL WIREWAY TO ACCESSIBLE CEILING. THIS IS REQUIRED FOR ALL DUAL CHANNEL WIREWAY LOCATIONS, EVEN WHERE NO DATA IS SHOWN.
6. COORDINATE ALL FLOOR BOX LOCATIONS WITH LABORATORY FURNISHING DRAWINGS PRIOR TO ROUGH-IN.
7. FOR WIREWAY DETAILS SEE 1 THRU 5/LE4.01.
8. PROVIDE (1) 1" C.O. STUBBED FROM EACH PEDESTAL TELE/DATA OUTLET TO ACCESSIBLE CEILING.
9. PROVIDE INDEPENDENT HOT AND NEUTRAL CONDUCTORS FOR EACH RECEPTACLE CIRCUIT IN A HOMERUN.
10. PROVIDE A MINIMUM OF (1)1-1/4"C.O. STUBBED FROM THE TEL/DATA SECTION OF EACH FLOOR BOX TO ACCESSIBLE CEILING.

1 PARTIAL POWER PLAN LEVEL 1
1/4" = 1'-0"

HGA
1918 Main Street, Third Floor
Santa Monica, California 90405
Telephone 310.557.7600

STRUCTURAL ENGINEER
SAIFUL BOUQUET
155 N LAKE AVE
PASADENA, CA 91101
626-304-2616

MECHANICAL & PLUMBING ENGINEER
STANTEC CONSULTING INC
14130 RIVERSIDE DR. # 201
SHERMAN OAKS, CA 91423
818-377-8220

ELECTRICAL ENGINEER
FBA ENGINEERING
150 PAULARINO AVE. #A120
COSTA MESA, CA 92626
949-852-9995

CIVIL ENGINEER
KPFF CONSULTING ENGINEERS
700 SOUTH FLOWER ST. #2100
LOS ANGELES, CA 90017
213-418-0201

LANDSCAPE ARCHITECT
LYNN CAPOUYA, INC.
17992 MITCHELL SOUTH, #110
IRVINE, CA 92614
949-756-0150

LABORATORY CONSULTANT
RESEARCH FACILITIES DESIGN
3965 FIFTH AVE. #400
SAN DIEGO, CA 92103
619-297-0159

SCIENCE CENTER
SANTA ANA COLLEGE

RANCHO SANTIAGO COMMUNITY COLLEGE DISTRICT

1530 W. 17TH ST.
SANTA ANA, CA 92706

SANTA ANA COLLEGE

I HEREBY CERTIFY THAT THIS PLAN, SPECIFICATION OR REPORT WAS PREPARED BY ME OR UNDER MY DIRECT SUPERVISION AND THAT I AM A DULY LICENSED ARCHITECT UNDER THE LAWS OF THE

NAME: KEVIN DONAGHEY — GUY J. CARPINO
DATE: SEPTEMBER 30, 2019 — JUNE 30, 2019
REGISTRATION NUMBER: C34799 — E 15951

APPROVED
DIVISION OF THE STATE ARCHITECT

ACS MP FLS JA SSR CNg

A# 04- 115788 DATE: 09.11.18

△NO	DESCRIPTION	DATE
2	Addendum 2	09/01/17
3	RFI #148	07/02/18
4	RFI #170	07/02/18
25	CCD-A-025	08/29/18

ISSUANCE HISTORY - THIS SHEET

DRAWN BY: Author — REVIEW BY: Approver

HGA NO: 3584-001-00

PARTIAL POWER PLAN LEVEL 1

DATE: JULY 06, 2017

MICHAEL WALL ENGINEERING
858-638-0600
858-638-0640 (fax)
www.mwalleng.com
4115 Sorrento Valley Blvd.
San Diego, CA 92121
REGISTERED ELECTRICAL ENGINEERS

LE2.01A

©COPYRIGHT HAMMEL, GREEN AND ABRAHAMSON, INC.

W:\PROJ16\16026\DWG\LE2.01A - PARTIAL POWER PLAN LEVEL 1.DWG Wednesday, August 29, 2018 8:12:46 AM - ABaker

MOUNTING: RECESSED | PANEL 2LP8 | VOLTAGE: 208Y/120V 3PH 4W
NEMA: 1 | BUS: 225A | MAIN: 150A | STATUS: NEW | FEEDER: 225A

Description	A	B	C	L	R	M	P	A			A	P	M	R	L	A	B	C	Description
214 WW RCPT.	720						1	20	1	A - -	2	20	1			180			214 RCPT.
214 WW RCPT.		540					1	20	3	- B -	4	20	1				1000		214 EQUIP.
214 FURIF.			1000				1	20	5	- - C	6	20	1						SPARE
214 CFH	1000						1	20	7	A - -	8	20	1			180			214 RCPT.
214 EQUIP.		1000					1	20	9	- B -	10	20	1				180		214 RCPT.
214 U.C. GLSVSH			1800				2	30	11	- - C	12	20	1					1040	214 ATCLV CNTRL
- - - - -	1800						-	-	13	A - -	14	20	1			60			214 CNPY HD LTG
214 U.C. GLSVSH		1000					1	20	15	- B -	16	20	1						SPARE
214 EQUIP.			1000				1	20	17	- - C	18	20	1						SPARE
SPARE							1	20	19	A - -	20	20	1						SPARE
SPARE							1	20	21	- B -	22	20	1						SPARE
SPARE							1	20	23	- - C	24	20	1						SPARE
SPARE							1	20	25	A - -	26	20	1						SPARE
SPARE							1	20	27	- B -	28	20	1						SPARE
SPARE							1	20	29	- - C	30	20	1						SPARE
SPARE							1	20	31	A - -	32	20	1						SPARE
SPARE							1	20	33	- B -	34	20	1						SPARE
SPARE							1	20	35	- - C	36	20	1						SPARE
SPARE							1	20	37	A - -	38	20	1						SPARE
SPARE							1	20	39	- B -	40	20	1						SPARE
SPARE							1	20	41	- - C	42	20	1						SPARE
	3520	2540	3800													420	1180	1040	

NOTES:
PHASE SUBTOTALS:
A - 3940 VA SUBTOTAL= 12500 VA
B - 3720 VA X 0.25LCL= 3125 VA
C - 4840 VA TOTAL= 15625 VA
43 AMPS

MOUNTING: RECESSED | PANEL 2LP4 | VOLTAGE: 208Y/120V 3PH 4W
NEMA: 1 | BUS: 225A | MAIN: 150A | STATUS: NEW | FEEDER: 225A

Description	A	B	C	L	R	M	P	A			A	P	M	R	L	A	B	C	Description
217 PEDESTALS	720						1	20	1	A - -	2	20	1			720			217 FLOORBOX
217 PEDESTALS		720					1	20	3	- B -	4	20	1				1000		217 PROJECTOR
217 PEDESTALS			720				1	20	5	- - C	6	20	1					1000	217 PROJECTOR
217 PEDESTALS	720						1	20	7	A - -	8	20	1			360			217 RCPT.
217 PEDESTALS		720					1	20	9	- B -	10	20	1				360		217 RCPT.
217 PEDESTALS			720				1	20	11	- - C	12	20	1					360	217 RCPT.
217 PEDESTALS	720						1	20	13	A - -	14	20	1			1000			217 EXAM LIGHT
217 PEDESTALS		720					1	20	15	- B -	16	20	1				180		217 RCPT.
217 PEDESTALS			720				1	20	17	- - C	18	20	1					400	217 CAMERA
217 PEDESTALS	720						1	20	19	A - -	20	20	1			250			PT DISP.
217 PEDESTALS		720					1	20	21	- B -	22	20	1						SPARE
217 PEDESTALS			720				1	20	23	- - C	24	20	1						SPARE
SPARE							1	20	25	A - -	26	20	1						SPARE
SPARE							1	20	27	- B -	28	20	1						SPARE
SPARE							1	20	29	- - C	30	20	1						SPARE
SPARE							1	20	31	A - -	32	20	1						SPARE
SPARE							1	20	33	- B -	34	20	1						SPARE
SPARE							1	20	35	- - C	36	20	1						SPARE
SPARE							1	20	37	A - -	38	20	1						SPARE
SPARE							1	20	39	- B -	40	20	1						SPARE
SPARE							1	20	41	- - C	42	20	1						SPARE
	2880	2880	2880													2330	1540	1760	

NOTES:
PHASE SUBTOTALS:
A - 5210 VA SUBTOTAL= 14270 VA
B - 4420 VA X 0.25LCL= 3568 VA
C - 4640 VA TOTAL= 17838 VA
50 AMPS

MOUNTING: RECESSED | PANEL 1LP4 | VOLTAGE: 208Y/120V 3PH 4W
NEMA: 1 | BUS: 225A | MAIN: 150A | STATUS: NEW | FEEDER: 225A

Description	A	B	C	L	R	M	P	A			A	P	M	R	L	A	B	C	Description
120 WW RCPT.	720						4	1	20	1	A - -	2	20	1		720			118 FLOORBOX
120 WW RCPT.		720					4	1	20	3	- B -	4	20	1			720		118 FLOORBOX
120 WW RCPT.			720				4	1	20	5	- - C	6	20	1				720	118 FLOORBOX
120 WW RCPT.	720						4	1	20	7	A - -	8	20	1		720			118 FLOORBOX
120 WW RCPT.		360					2	1	20	9	- B -	10	20	1			720		118 FLOORBOX
120 WW RCPT.			360				2	1	20	11	- - C	12	20	1				720	118 FLOORBOX
120 WW RCPT.	540						3	1	20	13	A - -	14	20	1		720			118 FLOORBOX
120 WW RCPT.		540					3	1	20	15	- B -	16	20	1			360		118 WW RCPT.
118 WW / PED.			360				2	1	20	17	- - C	18	20	1				180	118 WW RCPT.
118 WW RCPT.	180						1	1	20	19	A - -	20	20	1		360			118 RCPT.
118 RCPT.		540					3	1	20	21	- B -	22	20	1			1000		118 PROJECTOR
118 RCPT.			360				2	1	20	23	- - C	24	20	1				300	PT DISP.
SPARE								1	20	25	A - -	26	20	1					SPARE
SPARE								1	20	27	- B -	28	20	1					SPARE
SPARE								1	20	29	- - C	30	20	1					SPARE
SPARE								1	20	31	A - -	32	20	1					SPARE
SPARE								1	20	33	- B -	34	20	1					SPARE
SPARE								1	20	35	- - C	36	20	1					SPARE
SPARE								1	20	37	A - -	38	20	1					SPARE
SPARE								1	20	39	- B -	40	20	1					SPARE
SPARE								1	20	41	- - C	42	20	1					SPARE
	2160	2160	1800													2520	2800	1920	

NOTES:
PHASE SUBTOTALS:
A - 4680 VA SUBTOTAL= 13360 VA
B - 4960 VA X 0.25LCL= 3340 VA
C - 3720 VA TOTAL= 16700 VA
46 AMPS

MOUNTING: RECESSED | PANEL 1LP1 | VOLTAGE: 208Y/120V 3PH 4W
NEMA: 1 | BUS: 225A | MAIN: 150A | STATUS: NEW | FEEDER: 225A

Description	A	B	C	L	R	M	P	A			A	P	M	R	L	A	B	C	Description
134 OHSC RCPT	720					4	1	20	1	A - -	2	30	2			1800			134 EQUIP.
134 OHSC RCPT		720				4	1	20	3	- B -	4	-	-				1800		- - - - -
134 OHSC RCPT			720			4	1	20	5	- - C	6	30	2					1800	134 EQUIP.
134 OHSC RCPT	720					4	1	20	7	A - -	8	-	-			1800			- - - - -
134 OHSC RCPT		720				4	1	20	9	- B -	10	30	2				1800		134 EQUIP.
134 OHSC RCPT			720			4	1	20	11	- - C	12	-	-					1800	- - - - -
134 EQUIP.	1800						2	30	13	A - -	14	30	2			1800			134 EQUIP.
- - - - -		1800					-	-	15	- B -	16	-	-				1800		- - - - -
134 RCPT.			180				1	20	17	- - C	18	20	1					1000	134 RCPT.
134 EQUIP.	1000						1	20	19	A - -	20	20	1			1000			134 EQUIP.
134 EQUIP.		1000					1	20	21	- B -	22	20	1				1000		134 WW RCPT.
134 EQUIP.			1000				1	20	23	- - C	24	20	1					1000	134 WW RCPT.
134 CORD REEL	1000						1	20	25	A - -	26	20	1			1000			134 WW RCPT.
134 CORD REEL		1000					1	20	27	- B -	28	20	1				1000		134 EQUIP.
134 PROJECTOR			1000				1	20	29	- - C	30	20	1					1000	134 EQUIP.
134 PROJ. SCREEN	500						1	20	31	A - -	32	20	1			1000			134 EQUIP.
134 COMP. MILL		1440					3	20	33	- B -	34	20	1						SPARE
- - - - -			1440				-	-	35	- - C	36	20	1						SPARE
- - - - -	1440						-	-	37	A - -	38	20	1						SPARE
SPARE							1	20	39	- B -	40	20	1						SPARE
SPARE							1	20	41	- - C	42	20	1						SPARE
	7100	6680	5060													8400	7400	6600	

NOTES:
PHASE SUBTOTALS:
A - 15680 VA SUBTOTAL= 41320 VA
B - 14080 VA X 0.25LCL= 10330 VA
C - 11960 VA TOTAL= 51950 VA
143 AMPS

MOUNTING: RECESSED | PANEL 2LP9 | VOLTAGE: 208Y/120V 3PH 4W
NEMA: 1 | BUS: 225A | MAIN: 150A | STATUS: NEW | FEEDER: 225A

Description	A	B	C	L	R	M	P	A			A	P	M	R	L	A	B	C	Description
212 BENCH RCPT.	720						1	20	1	A - -	2	20	1			720			212 FLOORBOX
212 BENCH RCPT.		720					1	20	3	- B -	4	20	1				1000		212 PROJECTOR
212 BENCH RCPT.			720				1	20	5	- - C	6	20	1					1000	212 PROJECTOR
212 BENCH RCPT.	720						1	20	7	A - -	8	20	1			360			212 PEDESTAL
212 BENCH RCPT.		720					1	20	9	- B -	10	20	1				360		212 RCPT.
212 BENCH RCPT.			720				1	20	11	- - C	12	20	1					540	212 RCPT.
212 BENCH RCPT.	720						1	20	13	A - -	14	20	1			720			212 RCPT.
212 BENCH RCPT.		720					1	20	15	- B -	16	20	1				540		212 RCPT.
212 BENCH RCPT.			720				1	20	17	- - C	18	20	1					1000	212 CFH
212 BENCH RCPT.	720						1	20	19	A - -	20	20	1			1000			212 EQUIP.
212 BENCH RCPT.		720					1	20	21	- B -	22	20	1				1000		212 EQUIP.
212 BENCH RCPT.			720				1	20	23	- - C	24	20	1					1000	212 EQUIP.
PT DISP.	250						1	20	25	A - -	26	20	1			1000			212 REFRIG.
SPARE							1	20	27	- B -	28	20	1						SPARE
SPARE							1	20	29	- - C	30	20	1						SPARE
SPARE							1	20	31	A - -	32	20	1						SPARE
SPARE							1	20	33	- B -	34	20	1						SPARE
SPARE							1	20	35	- - C	36	20	1						SPARE
SPARE							1	20	37	A - -	38	20	1						SPARE
SPARE							1	20	39	- B -	40	20	1						SPARE
SPARE							1	20	41	- - C	42	20	1						SPARE
	3130	2880	2880													3800	2900	3540	

NOTES:
PHASE SUBTOTALS:
A - 6930 VA SUBTOTAL= 19130 VA
B - 5700 VA X 0.25LCL= 4783 VA
C - 6420 VA TOTAL= 23913 VA
66 AMPS

MOUNTING: RECESSED | PANEL 2LP5 | VOLTAGE: 208Y/120V 3PH 4W
NEMA: 1 | BUS: 225A | MAIN: 150A | STATUS: NEW | FEEDER: 225A

Description	A	B	C	L	R	M	P	A			A	P	M	R	L	A	B	C	Description
217-1 EXAM LIGHT	1000						1	20	1	A - -	2	20	1			1000			215 CFH
217-1 EXAM LIGHT		1000					1	20	3	- B -	4	20	1				1000		215 EQUIP.
217-1 EQUIP.			1000				1	20	5	- - C	6	20	1						SPARE
217-1 RCPT.	540						1	20	7	A - -	8	20	1			180			215 RCPT.
217-1 RCPT.		540					1	20	9	- B -	10	20	1						SPARE
SPARE							1	20	11	- - C	12	20	1						SPARE
SPARE							1	20	13	A - -	14	20	1						SPARE
SPARE							1	20	15	- B -	16	20	1						SPARE
SPARE							1	20	17	- - C	18	20	1						SPARE
SPARE							1	20	19	A - -	20	20	1						SPARE
SPARE							1	20	21	- B -	22	20	1						SPARE
SPARE							1	20	23	- - C	24	20	1						SPARE
SPARE							1	20	25	A - -	26	20	1						SPARE
SPARE							1	20	27	- B -	28	20	1						SPARE
SPARE							1	20	29	- - C	30	20	1						SPARE
SPARE							1	20	31	A - -	32	20	1						SPARE
SPARE							1	20	33	- B -	34	20	1						SPARE
SPARE							1	20	35	- - C	36	20	1						SPARE
SPARE							1	20	37	A - -	38	20	1						SPARE
SPARE							1	20	39	- B -	40	20	1						SPARE
SPARE							1	20	41	- - C	42	20	1						SPARE
	1540	1540	1000													1180	1000	0	

NOTES:
PHASE SUBTOTALS:
A - 2720 VA SUBTOTAL= 6260 VA
B - 2540 VA X 0.25LCL= 1565 VA
C - 1000 VA TOTAL= 7825 VA
22 AMPS

MOUNTING: RECESSED | PANEL 2LP1 | VOLTAGE: 208Y/120V 3PH 4W
NEMA: 1 | BUS: 225A | MAIN: 150A | STATUS: NEW | FEEDER: 225A

Description	A	B	C	L	R	M	P	A			A	P	M	R	L	A	B	C	Description
226 BENCH RCPT.	900						1	20	1	A - -	2	20	1			1000			226 FLOORBOX
226 BENCH RCPT.		720					1	20	3	- B -	4	20	1				1000		226 PROJECTOR
226 BENCH RCPT.			720				1	20	5	- - C	6	20	1					1000	226 PROJECTOR
226 BENCH RCPT.	900						1	20	7	A - -	8	20	1			360			226 RCPT.
226 BENCH RCPT.		720					1	20	9	- B -	10	20	1				540		226 RCPT.
226 BENCH RCPT.			720				1	20	11	- - C	12	20	1					540	226 RCPT.
226 BENCH RCPT.	900						1	20	13	A - -	14	20	1			360			226 RCPT.
226 BENCH RCPT.		720					1	20	15	- B -	16	20	1				1000		226 EQUIP.
226 BENCH RCPT.			720				1	20	17	- - C	18	20	1					1000	226 EQUIP.
226 BENCH RCPT.	900						1	20	19	A - -	20	20	1			540			226 WW RCPT.
226 BENCH RCPT.		720					1	20	21	- B -	22	20	1				360		226 WW RCPT.
226 BENCH RCPT.			720				1	20	23	- - C	24	20	1						SPARE
SPARE							1	20	25	A - -	26	20	1						SPARE
SPARE							1	20	27	- B -	28	20	1						SPARE
SPARE							1	20	29	- - C	30	20	1						SPARE
SPARE							1	20	31	A - -	32	20	1						SPARE
SPARE							1	20	33	- B -	34	20	1						SPARE
SPARE							1	20	35	- - C	36	20	1						SPARE
SPARE							1	20	37	A - -	38	20	1						SPARE
SPARE							1	20	39	- B -	40	20	1						SPARE
SPARE							1	20	41	- - C	42	20	1						SPARE
	3600	2880	2880													2260	2900	2540	

NOTES:
PHASE SUBTOTALS:
A - 5860 VA SUBTOTAL= 17060 VA
B - 5700 VA X 0.25LCL= 4265 VA
C - 5420 VA TOTAL= 21325 VA
59 AMPS

MOUNTING: RECESSED | PANEL 1LP2 | VOLTAGE: 208Y/120V 3PH 4W
NEMA: 1 | BUS: 225A | MAIN: 150A | STATUS: NEW | FEEDER: 225A

Description	A	B	C	L	R	M	P	A			A	P	M	R	L	A	B	C	Description
134 OHSC RCPT	720					4	1	20	1	A - -	2	30	2			1800			134 EQUIP.
134 OHSC RCPT		720				4	1	20	3	- B -	4	-	-				1800		- - - - -
134 OHSC RCPT			720			4	1	20	5	- - C	6	30	2					1800	134 EQUIP.
134 OHSC RCPT	720					4	1	20	7	A - -	8	-	-			1800			- - - - -
134 OHSC RCPT		720				4	1	20	9	- B -	10	30	2				1800		134 EQUIP.
134 OHSC RCPT			720			4	1	20	11	- - C	12	20	1					1800	134 EQUIP.
134 EQUIP.	1800						2	30	13	A - -	14	30	2			1800			134 EQUIP.
- - - - -		1800					-	-	15	- B -	16	-	-				1800		- - - - -
134 FLOORBOX			720				1	20	17	- - C	18	-	-					1800	- - - - -
134 FLOORBOX	720						1	20	19	A - -	20	20	1			1000			134 EQUIP.
134 FLOORBOX		720					1	20	21	- B -	22	20	1				1000		134 EQUIP.
134 CORD REEL			1000				1	20	23	- - C	24	20	1					360	134 RCPT.
134 CORD REEL	1000						1	20	25	A - -	26	20	1			1000			134 EQUIP.
134 PROJECTOR		1000				1	1	20	27	- B -	28	20	1				1000		134 EQUIP.
134 PROJ. SCREEN			500			1	1	20	29	- - C	30	20	1					1000	134 EQUIP.
132 WW RCPT.	540					3	1	20	31	A - -	32	20	1					150	PT DISP.
132 WW RCPT.		540				3	1	20	33	- B -	34	20	1					720	134 WW RCPT.
132 WW RCPT.			540			3	1	20	35	- - C	36	20	1					540	134 WW RCPT.
132 WW DED. REC	1000						1	20	37	A - -	38	20	1					540	134 WW RCPT.
132 WW DED. REC		1000					1	20	39	- B -	40	20	1						SPARE
132 RCPT.			500				1	20	41	- - C	42	20	1						SPARE
	6500	6500	4700													6030	7320	6500	

NOTES:
PHASE SUBTOTALS:
A - 13330 VA SUBTOTAL= 38350 VA
B - 13820 VA X 0.25LCL= 9588 VA
C - 11200 VA TOTAL= 47938 VA
133 AMPS

MOUNTING: RECESSED | PANEL 2LP6 | VOLTAGE: 208Y/120V 3PH 4W
NEMA: 1 | BUS: 225A | MAIN: 150A | STATUS: NEW | FEEDER: 225A

Description	A	B	C	L	R	M	P	A			A	P	M	R	L	A	B	C	Description
213 BENCH RCPT.	720						1	20	1	A - -	2	20	1			720			213 FLOORBOX
213 BENCH RCPT.		720					1	20	3	- B -	4	20	1				1000		213 PROJECTOR
213 BENCH RCPT.			540				1	20	5	- - C	6	20	1					1000	213 PROJECTOR
213 BENCH RCPT.	720						1	20	7	A - -	8	20	1			360			213 RCPT.
213 BENCH RCPT.		720					1	20	9	- B -	10	20	1				540		213 RCPT.
213 BENCH RCPT.			540				1	20	11	- - C	12	20	1					540	213 RCPT.
213 BENCH RCPT.	720						1	20	13	A - -	14	20	1			360			213 RCPT.
213 BENCH RCPT.		720					1	20	15	- B -	16	20	1				1000		213 CFH
213 BENCH RCPT.			540				1	20	17	- - C	18	20	1					540	213 RCPT.
213 BENCH RCPT.	720						1	20	19	A - -	20	20	1			540			213 RCPT.
213 BENCH RCPT.		720					1	20	21	- B -	22	20	1				360		213 RCPT.
213 BENCH RCPT.			540				1	20	23	- - C	24	20	1					1000	213 EQUIP.
PT DISP.	150						1	20	25	A - -	26	20	1			1000			213 EQUIP.
SPARE							1	20	27	- B -	28	20	1						SPARE
SPARE							1	20	29	- - C	30	20	1						SPARE
SPARE							1	20	31	A - -	32	20	1						SPARE
SPARE							1	20	33	- B -	34	20	1						SPARE
SPARE							1	20	35	- - C	36	20	1						SPARE
SPARE							1	20	37	A - -	38	20	1						SPARE
SPARE							1	20	39	- B -	40	20	1						SPARE
SPARE							1	20	41	- - C	42	20	1						SPARE
	3030	2880	2160													2880	2900	3060	

NOTES:
PHASE SUBTOTALS:
A - 6010 VA SUBTOTAL= 17030 VA
B - 5700 VA X 0.25LCL= 4258 VA
C - 5240 VA TOTAL= 21288 VA
59 AMPS

MOUNTING: RECESSED | PANEL 2LP2 | VOLTAGE: 208Y/120V 3PH 4W
NEMA: 1 | BUS: 225A | MAIN: 150A | STATUS: NEW | FEEDER: 225A

Description	A	B	C	L	R	M	P	A			A	P	M	R	L	A	B	C	Description
220 OHSC RCPT.	720						1	20	1	A - -	2	20	1			1000			220 CFH
220 OHSC RCPT.		720					1	20	3	- B -	4	20	1				360		220 RCPT.
220 EQUIP.			1000				1	20	5	- - C	6	20	1					360	220 RCPT.
220 EQUIP.	1000						1	20	7	A - -	8	20	1			250			PT DISP.
220 EQUIP.		1000					1	20	9	- B -	10	20	1						SPARE
220 EQUIP.			1000				1	20	11	- - C	12	20	1						SPARE
SPARE							1	20	13	A - -	14	20	1						SPARE
SPARE							1	20	15	- B -	16	20	1						SPARE
SPARE							1	20	17	- - C	18	20	1						SPARE
SPARE							1	20	19	A - -	20	20	1						SPARE
SPARE							1	20	21	- B -	22	20	1						SPARE
SPARE							1	20	23	- - C	24	20	1						SPARE
SPARE							1	20	25	A - -	26	20	1						SPARE
SPARE							1	20	27	- B -	28	20	1						SPARE
SPARE							1	20	29	- - C	30	20	1						SPARE
SPARE							1	20	31	A - -	32	20	1						SPARE
SPARE							1	20	33	- B -	34	20	1						SPARE
SPARE							1	20	35	- - C	36	20	1						SPARE
SPARE							1	20	37	A - -	38	20	1						SPARE
SPARE							1	20	39	- B -	40	20	1						SPARE
SPARE							1	20	41	- - C	42	20	1						SPARE
	1720	1720	2000													1250	360	360	

NOTES:
PHASE SUBTOTALS:
A - 2970 VA SUBTOTAL= 7410 VA
B - 2080 VA X 0.25LCL= 1853 VA
C - 2360 VA TOTAL= 9263 VA
26 AMPS

MOUNTING: RECESSED | PANEL 1LP3 | VOLTAGE: 208

3/13/2020: Reference Drawing for Bid #1384 Purchase of Engineering Equipment for New Science Center at SAC

ATTACHMENT C

NEW EQUIPMENT

E2

Bid Item #1
Compact
Mill

E5

Bid Item #3
Manual
Vision
System

E10

Bid Item #4
Robot
Training
Package

E18

Bid Item #2
Lathe
w/Turret
Automation
Package

E21

Bid Item #7
Mark Two
3D Printer

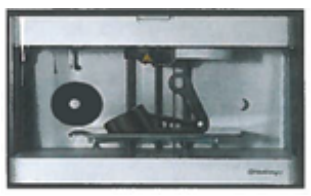

E22

Bid Item #6
Ultimaker
3 Extended
3D Printer

E25
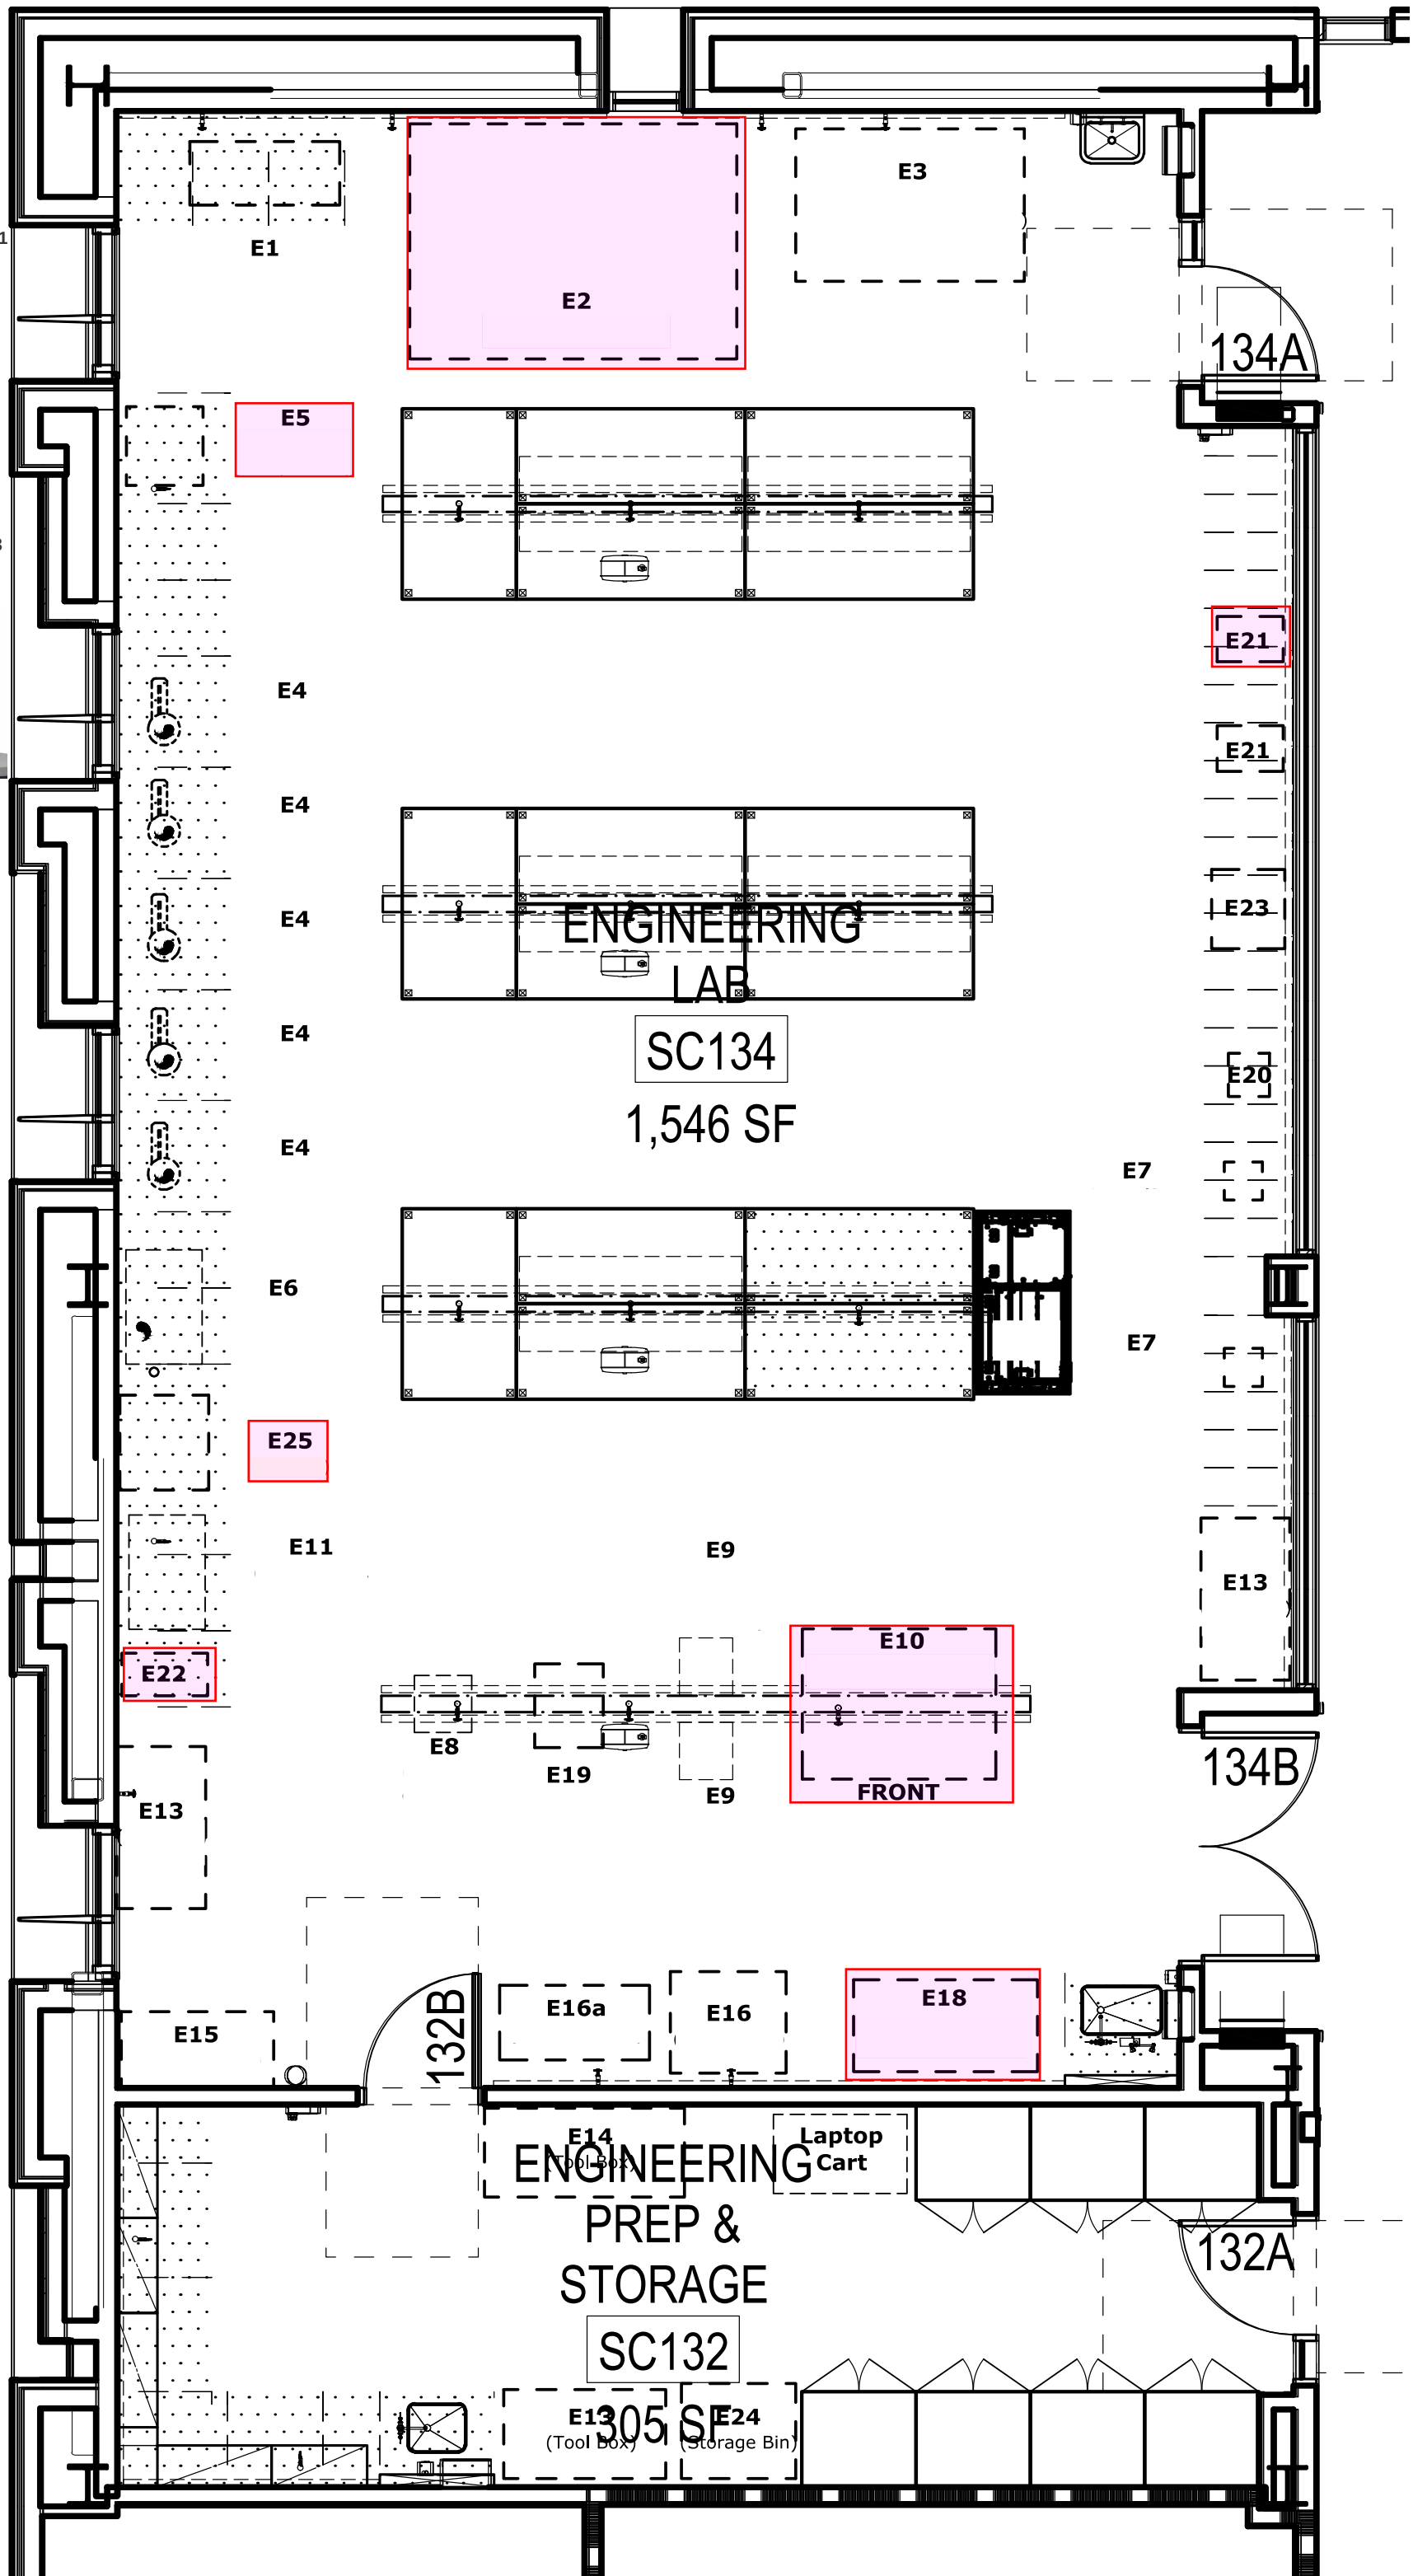
Bid Item #5
Tensile
Tester